


Map No. **KANSAS** Sec. 11 Twp. 23 R. 2W

Well No. 5-Hawthorn Farm Rockana Pet Coop Company

Still NORTH

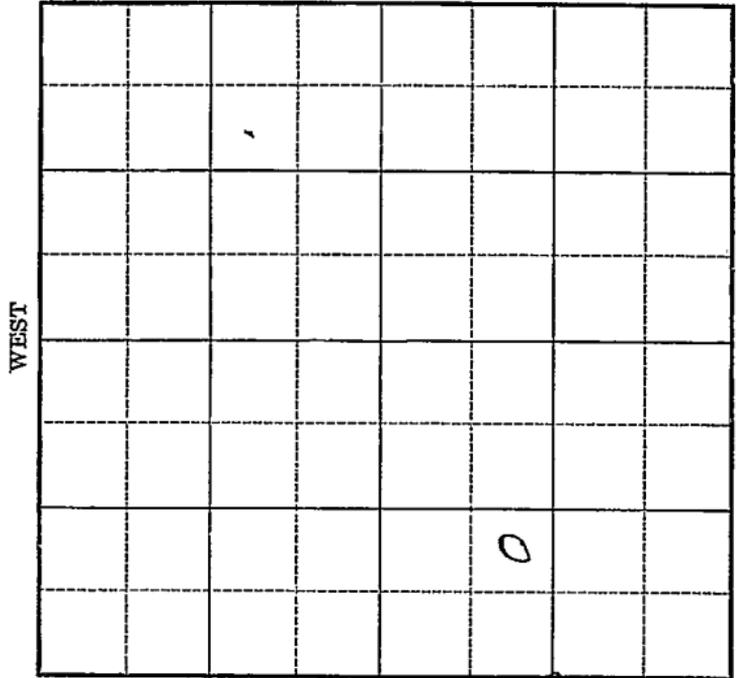

SOUTH **OWDD**

Location \_\_\_\_\_

Drilling Remarks \_\_\_\_\_

\_\_\_\_\_

\_\_\_\_\_

Rig Up \_\_\_\_\_

Drilling Remarks \_\_\_\_\_

\_\_\_\_\_

\_\_\_\_\_

**RECORD**

Cased \_\_\_\_\_ in. \_\_\_\_\_ ft.

Sand \_\_\_\_\_

Gas \_\_\_\_\_

Oil \_\_\_\_\_

Total Depth \_\_\_\_\_

**PRODUCTION**

1st 24 hrs. Nat. \_\_\_\_\_

1st 24 hrs. after shot \_\_\_\_\_

Gas \_\_\_\_\_ cu. ft.

Dry Hole \_\_\_\_\_

Abandoned \_\_\_\_\_

Map No. **KANSAS** Sec. 11 Twp. 23 R. 2w


Well No. 1-Hawry Farm  
Roxana Pet Corp Company  
(Shell)

\_\_\_\_\_ Ft. from N. Line

990 Ft. from S. Line

\_\_\_\_\_ Ft. from E. Line

990 Ft. from W. Line

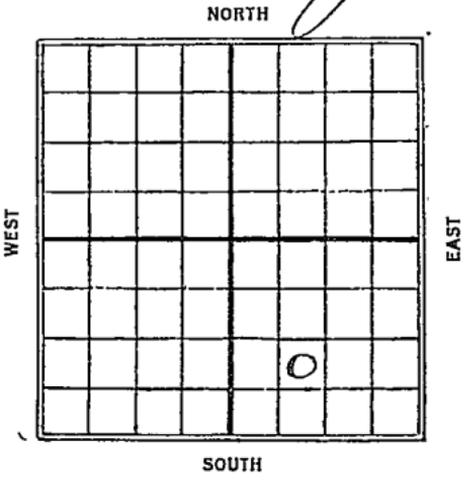

1928

Date	REPORT
3/28	R.O.G.
4/4	Rigging up-
4/11	Spud
4/18	Drlg 300
4/25	" 575
5/2	" 1000
5/9	" 1400
5/16	T.D. 1760 - u.R. 10"
5/23	Run 10" @ 1870
5/31	T.D. 2000 - u.R. 10"
6/6	Drlg 2073.
6/13	Top K.C. line 2278-
	T.D. 2288 - u.R. 10"
6/20	Drlg 2420 - H.F.W.
6/27	T.D. 2480 - u.R. 10"
7/3	T.D. 2540 - u.R. 10"
7/11	T.D. 2700 u.R. 8"
7/18	Drlg 2825 -
7/25	T.D. 2850 - u.R. 8"
8/1	Top chat 2940 - run'g 6"
8/3	T.D. 2965 in chat. 4 <sup>1</sup> / <sub>2</sub> dry gas. S.D. orders.

OWIDD (over)

8/7 - T.D. chat 2979-7M gas  
8/1 now making 5M

8/15 - Top chat 2940  
T. D. 2979

8 1/4 AM Gas

1010 R. P.

1929 OWDD

3/26 - Old T.D. 2979'

4/13 - Re gw up 2979 T.D.

4/10 - show oil 2985

rely 2990

4/17 - show oil at 3045'  
85 bbls 12 hr. - 28° gr.

4/24 —

5/1 - 6" - 3015' rely 3045'

5/8 - S.D. 3205'

5/15 - Base miss line 3295'

T.D. 3296' - WK 6"

5/22 - S.D. 3296'

5/29 - Cem. 6" - 3296'

6/5 - show oil 3329

T.D. 3341 - fsg tool

6/12 - siliceous line 3450'

~~show gas 2975 2977~~

~~show oil 2980 2982~~

~~5.29~~

HFW 3452 T.D. 3467-5D

6/19 —

6/26 —

7/2 —

7/10 —

7/17 - P.B. to 3050 fsg tool


7/24 - P.B. 2880' (Cem 8")

7/31 - S.D. 3060

Map No. **KANSAS** Sec. 11 Twp. 23 R. 2<sup>w</sup>

Well No. S 1- Harvey. Farm \_\_\_\_\_  
Shill Pet Company \_\_\_\_\_

\_\_\_\_\_ Ft. from N. Line  
990 Ft. from S. Line  
 \_\_\_\_\_ Ft. from E. Line  
990 Ft. from W. Line

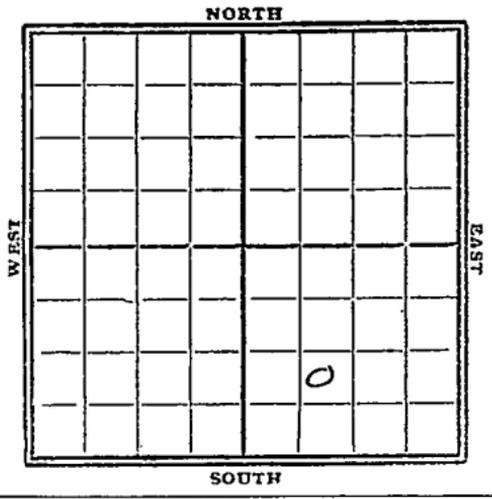

1929

Date	REPORT
8/7	S.D. 3060' T.D.
8/14	P.B. 3005 - will shoot
8/21	C.O.
8/28	—
9/4	swabbed 45 bbl oil and B.S. 24 hrs
9/11	C.O.
9/18	—
9/25	—
10/2	—
10/9	—
10/16	sand 2980-3005' T.D. 3554 P.B. to 3005' swab 70 bbl oil Comp.

**AWDD**

Map No. *KANSAS* Sec. *11* Twp. *23* R. *24*

Well No. *1 Haury*

*Roxana Oil Corp.* Company

Contractor

SECTION PLAT

		0	

----- Ft. from N. Line

*990* Ft. from S. Line

----- Ft. from E. Line

*990* Ft. from W. Line

FIRST REPORTS

Location -----

Rig up -----

Drilling and Remarks:

*R.O.G.*

RECORD

Cased ----- in., ----- ft.

Sand -----

Gas -----

Oil -----

Total Depth -----

PRODUCTION

1st 24 hrs. Nat. -----

1st 24 hrs. after shot -----

Gas ----- Cu. Ft.

Dry Hole -----

Abandoned -----

Date

MAR 28 1928

192

S. J. LEWIS

Scout

*Harvey*  
 MAP NO. **KANSAS** SEC. 11 TWP. 23 R. 2 W

WELL No. 1 Harvey  
Roxana P. & S. Corp COMPANY

CONTRACTOR

SECTION PLAT

		0	

\_\_\_\_\_ FT. FROM N. LINE

990 FT. FROM S. LINE

\_\_\_\_\_ FT. FROM E. LINE

990 FT. FROM W. LINE

**COMPLETED**

LOCATION \_\_\_\_\_

RIG UP \_\_\_\_\_

DRILLING AND REMARKS:

*Top Chad 2940*  
*Total depth.*  
*2979*  
*8 1/4 M. Gas.*  
*1010# Rock Press. etc*

RECORD

CASED \_\_\_\_\_ IN. \_\_\_\_\_ FT.

SAND \_\_\_\_\_

GAS \_\_\_\_\_

OIL \_\_\_\_\_

TOTAL DEPTH \_\_\_\_\_

PRODUCTION

1ST 24 HRS. NAT. \_\_\_\_\_

1ST 24 HRS. AFTER SHOT \_\_\_\_\_

GAS \_\_\_\_\_ CU. FT.

DRY HOLE \_\_\_\_\_

ABANDONED \_\_\_\_\_

DATE

AUG 15 1928

S. J. LEWIS

SCOUT

Map No. **KANSAS** Sec. 11 Twp. 23 R. 2W

Well No. Haury

Shell Oil Corp. Company

Contractor

**SECTION PLAT**

..... Ft. from N. Line

990 Ft. from S. Line

..... Ft. from E. Line

990 Ft. from W. Line


OW 11

Location.....

Rig up.....

Drilling and Remarks:

old total depth  
2979'

**RECORD**

Cased..... in., ..... ft.  
Sand.....  
Gas.....  
Oil.....  
Total Depth.....

**PRODUCTION**

1st 24 hrs. Nat.....  
1st 24 hrs. after shot.....  
Gas..... Cu. Ft.  
Dry Hole.....  
Abandoned.....

Date

MAR 27 1929  
..... 192.....

S. J. LEWIS Scout

*Harvey*  
 Map No. **KANSAS** Sec. 11 Twp. 23 R. 2W  
 Well No. 39 *Harvey*

*Shell Oil Co.* Company  
 Contractor

SECTION PLAT

..... Ft. from N. Line  
990 Ft. from S. Line  
 ..... Ft. from E. Line  
990 Ft. from W. Line

		0	

COMPLETED

Location.....  
 Rig up.....  
 Drilling and Remarks:  
*P.B. 3005*  
*Swath 7088 ft*

RECORD

Cased..... in., ..... ft.  
 Sand 2988-3005  
 Gas.....  
 Oil.....  
 Total Depth 3554

PRODUCTION

1st 24 hrs. Nat.....  
 1st 24 hrs. after shot.....  
 Gas..... Cu. Ft.  
 Dry Hole.....  
 Abandoned.....

Date OCT 16 1929 *1929* **S. J. LEWIS** Scout