

Form 51-5M-4-27-27423

Well No. #1-B ~~XXXX~~ Harves Farm

Kovada Fib. Co. Company

McPherson O & G and Shell Pet


SOUTH

OWDID

Location_____

Drilling Remarks

Rig Up_____

Drilling Remarks

RECORD

Cased_____in. _____ft.

Sand

Gas _____

Oil _____

Total Depth_____

PRODUCTION

1st 24 hrs. Nat. _____

1st 24 hrs. after shot_____

Gas _____ cu. ft.

Dry Hole

Abandoned _____


Map No. **KANSAS** Sec. 11 Twp. 23 R. 2W
1-B
Well No. ~~XXXX~~ - Harvey Farm
Roxana Company
McPherson O & G and Shell Pet

990 Ft. from N. Line

..... Ft. from S. Line

990 Ft. from E. Line

..... Ft. from W. Line

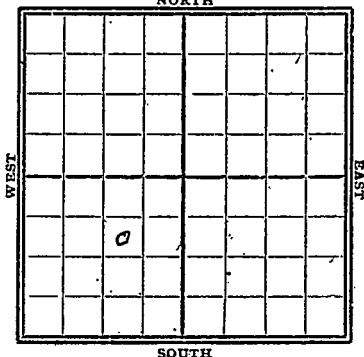

1928

Date	REPORT
8/22	Location
9/15	Spud
9/12	Spud 250'
9/19	Drly 790'
9/26	" 890'
10/3	" 2030'
10/10	T.D. 2140 Log bit
10/17	Cement off tools
10/24	
10/31	
11/7	run 8"- 2140'
11/14	Skid 50' east
11/21	Re-bldy Rig
11/28	Spud
12/5	Spud 450'
12/12	Drly 1185'
12/19	" 1740'
12/26	" 2200'
1929	
1/2	" 2453'
1/9	HF W 2458'-80'
	drly 2480'

1/16- drlg 2687'
 1/23- " 2890'
 1/30- S.D. 2890' T.D.
 2/6- drlg 2890'
 2/13- UPR 8"-2850' T.D.
 2/20- drlg 2938'
 2/27- Poreing 2942'-T.D.
 3/5- Top chat 2955' T.D.
 1 A gas
 3/6- Sem 8"-2955 1/2' T.D.
 est 1 A gas
 3/11- Top chat 2955'
 2 A gas at 2955 1/2'
 Now: 40 A gas
 3/13- T.D. 2955 1/2'
 Est 43 A gas-shut in
 3/20- Shot 2955'
 well blew in for
 43 A gas
 T.D. not determined
 990# rock pressure
 Sump.
 1930 O.W.D.D.
 10/15- Old T.D. 2955 1/2'
 Bldg rig
 10/23- show oil & water 2956
 dry 2958'
 10/29- show oil 2988
 dry 2990
 11/5- TV 3000'
 dry & Abandon

MAP No. KANSAS SEC. 11 TWP. 23 R. 2N

WELL No. 1-A Harry

Roxana P. H. Corp. COMPANY

CONTRACTOR

SECTION PLAT

	0		

990 FT. FROM N. LINE

FT. FROM S. LINE

990 FT. FROM E. LINE

FT. FROM W. LINE

FIRST REPORTS

LOCATION ✓

RIG UP

DRILLING AND REMARKS:

RECORD

CASED IN. FT.

SAND

GAS

OIL

TOTAL DEPTH

PRODUCTION

1ST 24 HRS. NAT.

1ST 24 HRS. AFTER SHOT

GAS CU. FT.

DRY HOLE

ABANDONED

DATE

AUG 22 1928

S. J. LEWIS

SCOUT

MAP No. LANZ SEC. 11 TWP. 23 R. 2W

WELL No. W-A Harry

Roxana Oil Corp COMPANY

CONTRACTOR

SECTION PLAT

990 FT. FROM N. LINE

FT. FROM S. LINE

990 FT. FROM E. LINE

FT. FROM W. LINE

COMPLETED

LOCATION _____

RIG UP _____

DRILLING AND REMARKS:

Chd 29.50
flow in & down
know total depth

43 M Gas

990 lbs Rock pr

RECORD

CASED _____ IN. _____ FT.

SAND _____

GAS _____

OIL _____

TOTAL DEPTH _____

PRODUCTION

1ST 24 HRS. NAT. _____

1ST 24 HRS. AFTER SHOT _____

GAS _____ CU. FT.

DRY HOLE _____

ABANDONED _____

DATE

MAR 20 1929

192

SCOUT

Harvey
 Map No. **KANSAS** Sec. *11* Twp. *23* R. *2 W*
39
 Well No. *1-B Harvey*

McPherson Drilling & Oil Co. Company

Contractor

SECTION PLAT

	0		

990 Ft. from N. Line

..... Ft. from S. Line

990 Ft. from E. Line

..... Ft. from W. Line

OWN IT

Location.....

Rig up.....

Drilling and Remarks:

Old TII 2955 1/2

Building rig

RECORD

Cased.....in.,ft.

Sand.....

Gas.....

Oil.....

Total Depth.....

PRODUCTION

1st 24 hrs. Nat.....

1st 24 hrs. after shot.....

Gas.....Cu. Ft.

Dry Hole.....

Abandoned.....

Date

OCT 15 1930

S. J. LEWIS

Scout

Harvey
 Map No. **KANSAS** Sec. 11 Twp. 29 R. 2W
 Well No. 1-B *Harvey*

McPherson & G. S. Shell Company

Contractor

SECTION PLAT

	0		

990 Ft. from N. Line

..... Ft. from S. Line

990 Ft. from E. Line

..... Ft. from W. Line

ABANDONED

Location.....

Rig up.....

Drilling and Remarks:

RECORD

Cased..... in., ft.

Sand.....

Gas.....

Oil.....

Total Depth 800

PRODUCTION

1st 24 hrs. Nat.....

1st 24 hrs. after shot.....

Gas..... Cu. Ft.

Dry Hole.....

Abandoned.....

Date

NOV 5 1930
 192..... S. J. LEWIS Scout