


Section 11 Township 23 Range 2-W

Well Number 1 Haury "B"

Company Palmer et al

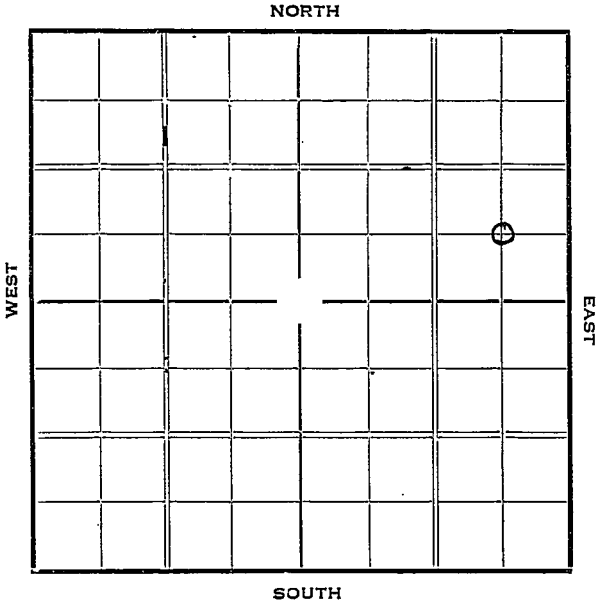

Sec. 11 Twp. 23 R. 2-W

Well No. #1 Haury "B" Farm
Palmer et al Company


 Ft. from N. Line

660 Ft. from S. Line

660 Ft. from E. Line

 Ft. from W. Line

Elev. 1453

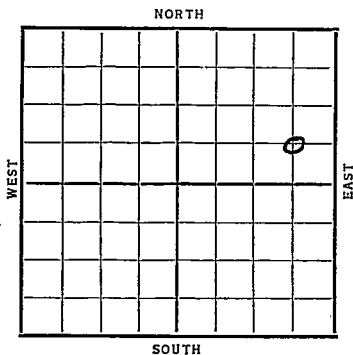

Date	REPORT
1936	
11/25	Cellar
12/3	"
12/10	Rigging up.
12/17	12" @ 140'. Drlg. 2100'.
1937	
1/6	Chat 2948'. T. D. 2982'.
	2000 acid.
	Pot. 865 bbls. 12 hrs.
	COMPLETED

Map No. 39 Sec. 11 Twp. 23 R. 2W

Well No. 1 Harry "B"

Palmer & Co Company

Contractor

SECTION PLAT

			o

_____ Ft. from N. Line

660 Ft. from S. Line

660 Ft. from E. Line

_____ Ft. from W. Line

FIRST REPORT

Location _____

Rig up _____

Drilling and Remarks:

cellar

RECORD

Cased _____ in., _____ ft.

Sand _____

Gas _____

Oil _____

Total Depth _____

PRODUCTION

1st 24 hrs. Nat. _____

1st 24 hrs. after shot _____

Gas _____ Cu. Ft.

Dry Hole _____

Abandoned _____

Date

NOV 25 1936 19

S. J. LEWIS Scout

KANSAS

Map No. 39 Sec. 11 Twp. 23 R. 24

Well No. 1 Harry "B"

Palmer & Co Company

Contractor

SECTION PLAT

			0

_____ Ft. from N. Line

660 Ft. from S. Line

660 Ft. from E. Line

_____ Ft. from W. Line

COMPLETED

Location _____

Rig up _____

Drilling and Remarks:

Chas 2948

2000 acid

Pa 8865-12 hrs

RECORD

Cased _____ in., _____ ft.

Sand _____

Gas _____

Oil _____

Total Depth 2982

PRODUCTION

1st 24 hrs. Nat. _____

1st 24 hrs. after shot _____

Gas _____ Cu. Ft.

Dry Hole _____

Abandoned _____

Date

JAN 6 1937 19

S. J. LEWIS Scout