


*Keno*

Form 51-5M-5-34-Palace

Map No. KANSA Sec. 11 Twp. 23 R. 4W

Well No. 4 Robin Farm  
Skelly Oil Company

NORTH

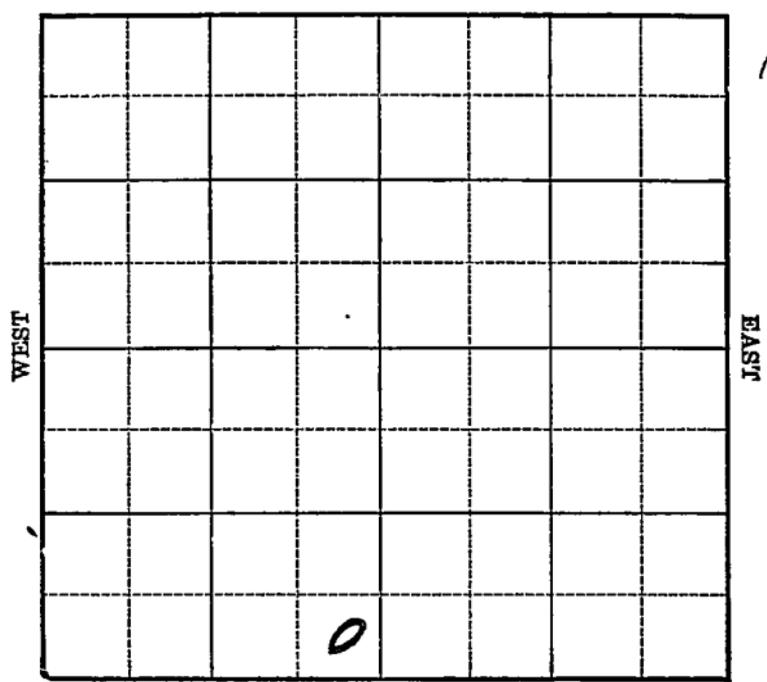

SOUTH

Location \_\_\_\_\_

Drilling Remarks \_\_\_\_\_

\_\_\_\_\_

\_\_\_\_\_

Rig Up \_\_\_\_\_

Drilling Remarks \_\_\_\_\_

\_\_\_\_\_

\_\_\_\_\_

**RECORD**

Cased \_\_\_\_\_ in. \_\_\_\_\_ ft.

Sand \_\_\_\_\_

Gas \_\_\_\_\_

Oil \_\_\_\_\_

Total Depth \_\_\_\_\_

**PRODUCTION**

1st 24 hrs. Nat. \_\_\_\_\_

1st 24 hrs. after shot \_\_\_\_\_

Gas \_\_\_\_\_ cu. ft.

Dry Hole \_\_\_\_\_

Abandoned \_\_\_\_\_

*Reno*

Map No. KANSAS Sec. 11 Twp. 23 R. 40

Well No. 4 Robin Farm


Skelly Oil Company

\_\_\_\_\_ Ft. from N. Line

330 Ft. from S. Line

330 Ft. from E. Line

\_\_\_\_\_ Ft. from W. Line

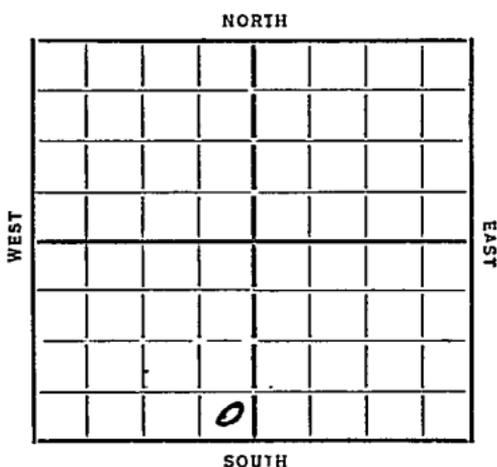

Date 1934

REPORT

11/27 *Cellar*  
12/6 *Qty 150*  
12/13 *12 1/2 531 57 752*  
12/21 *57 1232*  
12/27 *Qty 2345*  
1/3/35 *" 2750*  
1/10 *Chat 3290 13 9ML 3503*  
1/17 *Hinton 3613 TD 3620 Coing*  
1/17 *TD 3622 12 475 Bbls 12 lbs*  
*2000 acid*  
1/23 *Hinton 3613 TD 3622*  
*2000 acid 1919 Bbls.*

COMPLETED

Map No. 40 Sec. 11 Twp. 23 R. 4W

Well No. 4 - Sabin

Spelly oil Company

Contractor

FIRST REPORTS

SECTION PLAT


Ft. from N. Line

330

Ft. from S. Line

330

Ft. from E. Line

Ft. from W. Line

Location.....

Rig up.....

Drilling and Remarks: .

*cellar*

RECORD

Cased..... in., .....ft.

Sand.....

Gas.....

Oil.....

Total Depth.....

PRODUCTION

1st 24 hrs. Nat.....

1st 24 hrs. after shot.....

Gas..... Cu. Ft.

Dry Hole.....

Abandoned.....

Date

11-27-34 192

ORVAL MANNSCHRECK

Scout

