


Reno

Form 51-5M-5-34-Palace

Map No. \_\_\_\_\_ Sec. 11 Twp. 23 R. 4W

Well No. 5 Robin Farm \_\_\_\_\_  
Shelley Oil Company \_\_\_\_\_

NORTH

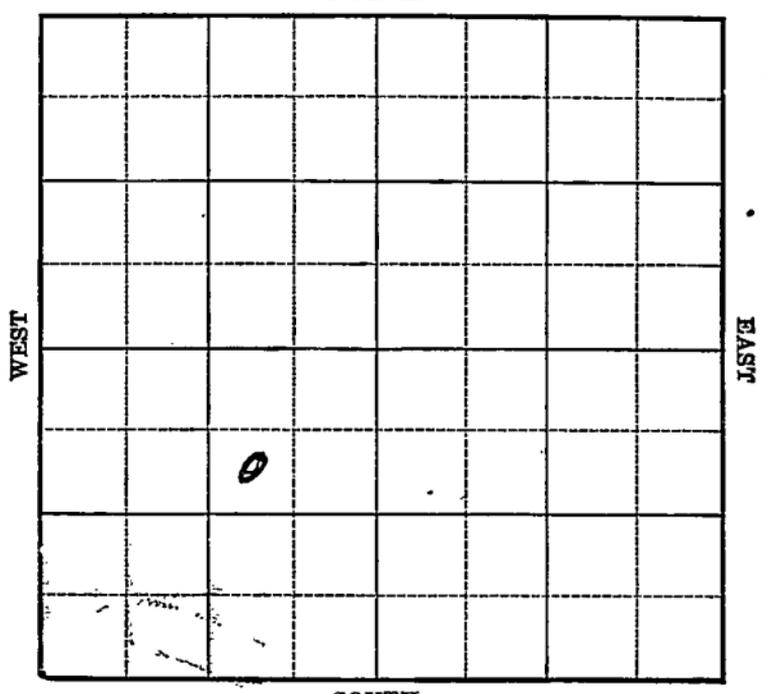

SOUTH

Location \_\_\_\_\_

Drilling Remarks \_\_\_\_\_

\_\_\_\_\_

\_\_\_\_\_

Rig Up \_\_\_\_\_

Drilling Remarks \_\_\_\_\_

\_\_\_\_\_

\_\_\_\_\_

**RECORD**

Cased \_\_\_\_\_ in. \_\_\_\_\_ ft.

Sand \_\_\_\_\_

Gas \_\_\_\_\_

Oil \_\_\_\_\_

Total Depth \_\_\_\_\_

**PRODUCTION**

1st 24 hrs. Nat. \_\_\_\_\_

1st 24 hrs. after shot \_\_\_\_\_

Gas \_\_\_\_\_ cu. ft. \_\_\_\_\_

Dry Hole \_\_\_\_\_

Abandoned \_\_\_\_\_

*Revo*

Map No. KANSAS Sec. 11 Twp. 23 R. 4W


Well No. #5 Robin Farm \_\_\_\_\_  
Skelly Oil Company \_\_\_\_\_

990 Ft. from N. Line

\_\_\_\_\_ Ft. from S. Line

990 Ft. from E. Line

\_\_\_\_\_ Ft. from W. Line

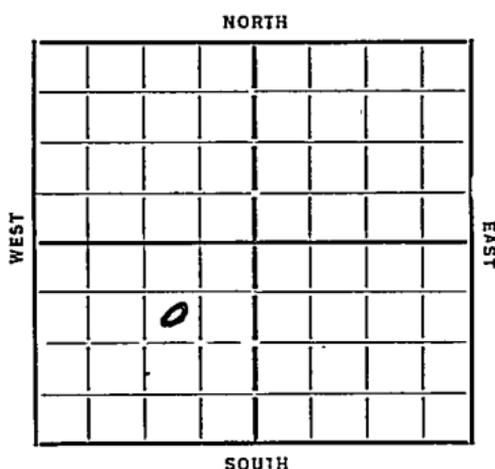

Date 7/35

REPORT

1/23 Cellar

1/31

2/7 526 Crooked Hole

2/14 15 1/2 126 17 1/2 523 WOC

2/21 Relg 2065

2/28 " 3160 KC 2578

3/7 Chat 3278 Henton 3560  
3565-TD Rust

3/14 TD 3591 3584-91 Sho Water

3/21 WX 3872

3/28

4/3 Henton 3560 TD 3872  
113 3465 Shot 80 gts  
5 M Gas  
6 Bbls oil  
68 Bbls Water

COMPLETED

Map No. 40 Sec. 11 Twp. 23 R. 4W

Well No. 5- Sabine

Skelly Oil Company

Contractor

**FIRST REPORTS**

**SECTION PLAT**

990 Ft. from N. Line

..... Ft. from S. Line

990 Ft. from E. Line

..... Ft. from W. Line

	0		

Location.....

Rig up.....

Drilling and Remarks:

*cellar*

**RECORD**

Cased.....in., .....ft.

Sand.....

Gas.....

Oil.....

Total Depth.....

**PRODUCTION**

1st 24 hrs. Nat.....

1st 24 hrs. after shot.....

Gas.....Cu. Ft.

Dry Hole.....

Abandoned.....

Date

1-23-35 192.....

**ORVAL MANSCHRECK**

Scout

Map No. 40 Sec. 11 Twp. 23 R. 4W

Well No. 5- Rabin

Spelly oil Company

Contractor



SECTION PLAT

990 Ft. from N. Line

..... Ft. from S. Line

990 Ft. from E. Line

..... Ft. from W. Line

	0		

Location.....

Rig up.....

Drilling and Remarks:

PB 3465  
shot 80 qts  
5 m gas  
6 bbls oil  
68 bbls water

RECORD

Cased..... in., ..... ft.

Sand Hutton 3560

Gas.....

Oil.....

Total Depth 3872

PRODUCTION

1st 24 hrs. Nat.....

1st 24 hrs. after shot.....

Gas..... Cu. Ft.

Dry Hole.....

Abandoned.....

Date

4-3-35 192..... **ORVAL MANNSCHRECK** Scout