


Map No. **KANSAS** Sec. **11** Twp. **23** R. **4<sup>w</sup>** *Reno*

Well No. **2-A Robin** Farm \_\_\_\_\_  
**Barnes Oil** Company

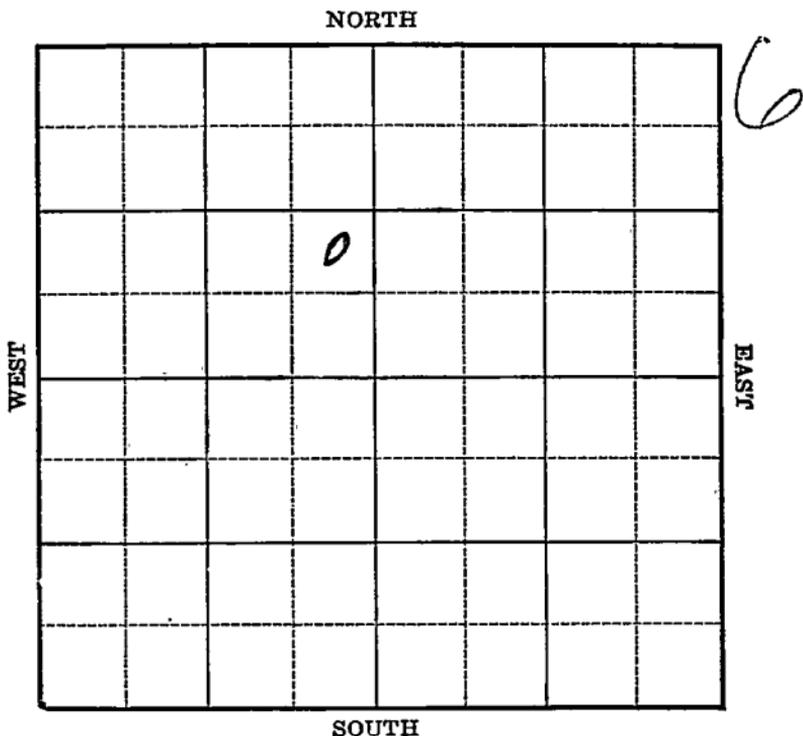

Location \_\_\_\_\_

Drilling Remarks \_\_\_\_\_

\_\_\_\_\_

\_\_\_\_\_

**RECORD**

Cased \_\_\_\_\_ in. \_\_\_\_\_ ft.

Sand \_\_\_\_\_

Gas \_\_\_\_\_

Oil \_\_\_\_\_

Total Depth \_\_\_\_\_

Rig Up \_\_\_\_\_

Drilling Remarks \_\_\_\_\_

\_\_\_\_\_

\_\_\_\_\_

**PRODUCTION**

1st 24 hrs. Nat. \_\_\_\_\_

1st 24 hrs. after shot \_\_\_\_\_

Gas \_\_\_\_\_ cu. ft.

Dry Hole \_\_\_\_\_


Abandoned \_\_\_\_\_

Reno

Map No. KANSAS Sec. 11 Twp. 23 R. 4W

Well No. 2-A Sabin Farm  
Burnsdell Company

       Ft. from N. Line  
990 Ft. from S. Line  
330 Ft. from E. Line  
       Ft. from W. Line

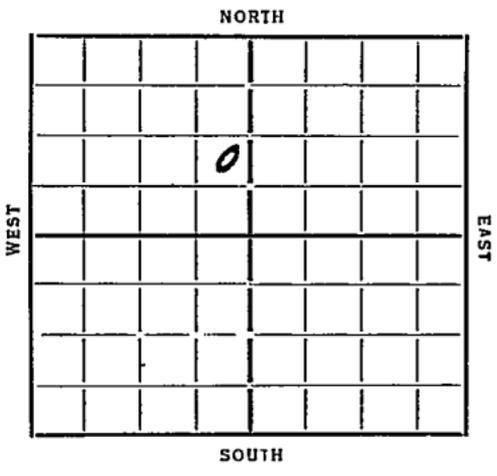

Date

REPORT

1935  
3/20 Rig  
3/28 Rgn  
4/4 Rly 1700 16" 239  
4/11 " 3180  
4/18 " 3420 T @ 3764  
4/26 TH 3609 898 3608  
T7 3622 Rust  
5/2 308 oil 1000 acid  
5/8 Hutton 3609 T7 3622 1/2  
1000 acid  
1145 Rbly  
Cut 15%

**COMPLETED**

Map No. 40 Sec. 11 Twp. 23 R. 4W

Well No. 2A- Sabine

Barnsdall oil Company

Contractor

FIRST REPORTS

SECTION PLAT

..... Ft. from N. Line

990 Ft. from S. Line

330 Ft. from E. Line

..... Ft. from W. Line

|  |   |  |  |
|--|---|--|--|
|  |   |  |  |
|  | 0 |  |  |
|  |   |  |  |
|  |   |  |  |
|  |   |  |  |

Location.....

Rig up.....

Drilling and Remarks:

*Rig*

RECORD

Cased..... in., ..... ft.

Sand.....

Gas.....

Oil.....

Total Depth.....

PRODUCTION

1st 24 hrs. Nat.....

1st 24 hrs. after shot.....

Gas..... Cu. Ft.

Dry Hole.....

Abandoned.....

Date

3-20-35

192

UNVAL MANSCHRECK

Scout

Map No. 40 Sec. 11 Twp. 23 R. 4W

Well No. 27-Sabin

Barnsdall Oil Company

Contractor

**COMPLETED**

SECTION PLAT

|  |   |  |  |
|--|---|--|--|
|  |   |  |  |
|  | 0 |  |  |
|  |   |  |  |
|  |   |  |  |
|  |   |  |  |

..... Ft. from N. Line

990 Ft. from S. Line

330 Ft. from E. Line

..... Ft. from W. Line

Location.....

Rig up.....

Drilling and Remarks:

100 sand  
1145 fth  
cut 15%

RECORD

Cased..... in, ..... ft.

Sand Hunter 3609

Gas.....

Oil.....

Total Depth 3622 1/2

PRODUCTION

1st 24 hrs. Nat.....

1st 24 hrs. after shot.....

Gas..... Cu. Ft.

Dry Hole.....

Abandoned.....

Date

5-8-35 192.....

**ORVAL MANNSCHRECK**  
Scout