



Reno

KANSAS

Map No. \_\_\_\_\_ Sec. 11 Twp. 23 R. 4W

Well No. 5 Sabin "B" Farm


Barnsdall Company

330 Ft. from N. Line

\_\_\_\_\_ Ft. from S. Line

990 Ft. from E. Line

\_\_\_\_\_ Ft. from W. Line

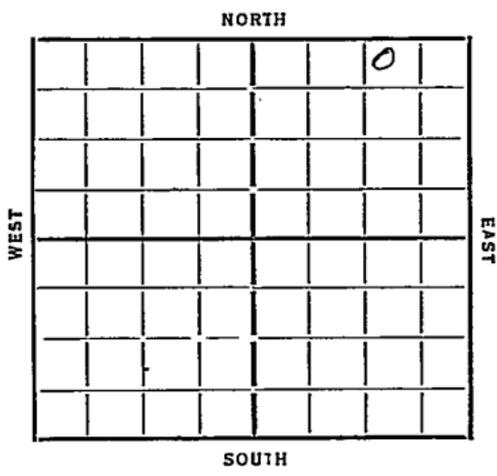

Date 1934

REPORT

<u>8/15</u>	<u>location</u>		
<u>8/23</u>	<u>B.R.</u>		
<u>8/30</u>	<u>blg 580</u>	<u>15 1/2</u>	<u>134</u>
<u>9/6</u>	<u>" 2120</u>	<u>12"</u>	<u>601</u>
<u>9/13</u>	<u>" 2919</u>		
<u>9/20</u>	<u>" 3370</u>	<u>chat</u>	<u>3260</u>
<u>9/27</u>	<u>8'4 3602</u>	<u>Huntou</u>	<u>3603</u>
	<u>T.D 3604</u>	<u>blg plug</u>	
<u>10/3</u>	<u>Huntou 3603</u>	<u>T.D</u>	<u>3610</u>
	<u>1718 Bbls.</u>		

COMPLETED

KANSAS

Map No. 40 Sec. 11 Twp. 23 R. 4W

Well No. 5 - Sabin 'B'

Barnsdall Oil Company

Contractor

FIRST REPORTS

330 Ft. from N. Line

\_\_\_\_\_ Ft. from S. Line

790 Ft. from E. Line

\_\_\_\_\_ Ft. from W. Line

SECTION PLAT

			0

Location ✓

Rig up \_\_\_\_\_

Drilling and Remarks:

RECORD

Cased \_\_\_\_\_ in., \_\_\_\_\_ ft.

Sand \_\_\_\_\_

Gas \_\_\_\_\_

Oil \_\_\_\_\_

Total Depth \_\_\_\_\_

PRODUCTION

1st 24 hrs. Nat. \_\_\_\_\_

1st 24 hrs. after shot \_\_\_\_\_

Gas \_\_\_\_\_ Cu. Ft.

Dry Hole \_\_\_\_\_

Abandoned \_\_\_\_\_

Date

8-15-34 19

ORVAL MANNSCHRECK

Scout

Map No. 40 Sec. 11 Twp. 23 R. 4W

Well No. 5 - Sabin 'B'

Barnsdall Company

Contractor

**COMPLETED** SECTION PLAT

330 Ft. from N. Line

..... Ft. from S. Line

990 Ft. from E. Line

..... Ft. from W. Line

			0

Location.....

Rig up.....

Drilling and Remarks:

1718 lbs

**RECORD**

Cased..... in., ..... ft.

Sand Hunton 360.3

Gas.....

Oil.....

Total Depth 3610

**PRODUCTION**

1st 24 hrs. Nat.....

1st 24 hrs. after shot.....

Gas..... Cu. Ft.

Dry Hole.....

Abandoned.....

Date

**ORVAL MANNSCHRECK**

10-3-34 192.....

Scout