


Reno

Form 51-5M-5-34-Palace

Map No. KANSA Sec. 11 Twp. 23 R. 4^W

Well No. 1-C Robin Farm
Barnsdall Company

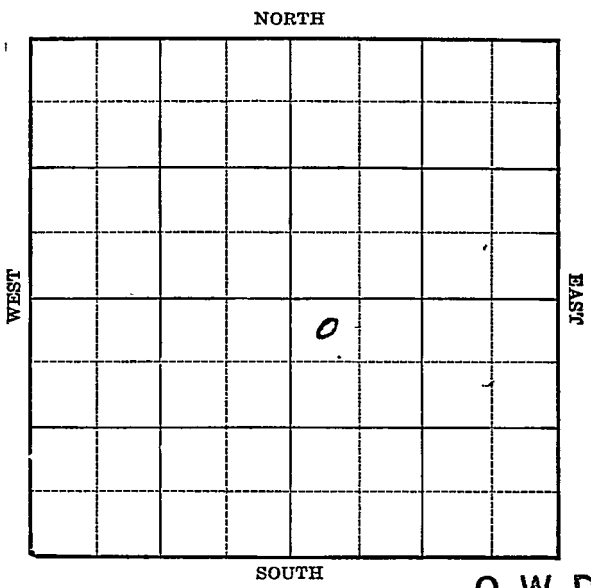

O. W. D. D

Location _____
Drilling Remarks _____

Rig Up _____
Drilling Remarks _____

RECORD

Cased _____ in. _____ ft.
Sand _____
Gas _____
Oil _____
Total Depth _____

PRODUCTION

1st 24 hrs. Nat. _____
1st 24 hrs. after shot _____
Gas _____ cu. ft. _____
Dry Hole _____
Abandoned _____

Reno


Map No. KANSAS Sec. 11 Twp. 23 R. 4^W
Well No. 1-C Robin Farm
Barnes Company

330 Ft. from N. Line

_____ Ft. from S. Line

_____ Ft. from E. Line

330 Ft. from W. Line

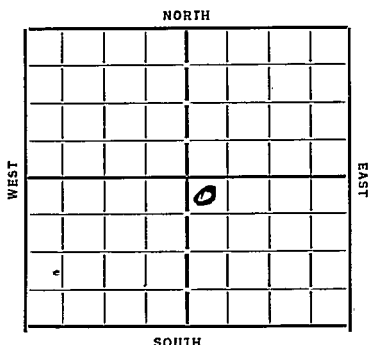

Date	REPORT	O. W. D. D
1934		
7/25	Cellar	
8/2	— 8/9 — 8/16 —	
8/23	Rign	
8/30	Dlg 663 15 1/2 139 15 1/2 599	
9/6	" 2600 NCL 2554	
9/13	" 3310	
9/20	Base line 3445 T Hutton s.o.	
9/26	Hutton 3540 TD 3556	
	1052 Bbls.	
	COMPLETED	
1938	O. W. D. D	
8/3	Rigging up.	
8/12	Base Hutton 3595.	
	Viola 365411 ADlg. 36601. 24	
	h.o.r. 7. D.O.	
	OVER	

1938

8/19 7" - 3674'. S. O. 3683-95'.
Wilcox 3691'. 1 Bailer oil
per hr. 3695-98'.
2000' water. 3700-10'.
Dlg. 3763'.

8/26 Arb. 3769'. 7" - 3770'.
T. D. 3775'. 1000' oil in 5
hours.

8/31 7" at 3770'.
Arb. - 3769'.
T. D. - 3775'.
2000 acid.
Potential 108 bbls.
Lots of water.

COMPLETED

KANSAS

Map No. 40 Sec. 11 Twp. 23 R. 4WWell No. 1C - Sabin
Barnsdall Company

Contractor

FIRST REPORTS

SECTION PLAT

		0	

330 Ft. from N. Line

_____ Ft. from S. Line

_____ Ft. from E. Line

330 Ft. from W. Line

Location _____

Rig up _____

Drilling and Remarks:

cellar

RECORD

Cased _____ in., _____ ft.

Sand _____

Gas _____

Oil _____

Total Depth _____

PRODUCTION

1st 24 hrs. Nat. _____

1st 24 hrs. after shot _____

Gas _____ Cu. Ft.

Dry Hole _____

Abandoned _____

Date

7-25-31 19

ORVAL MANNSCHRECK

Scout

KANSAS

Form 26-1M Bks. 2-29

Map No. 40 Sec. 11 Twp. 23 R. 4WWell No. 1C - SabinBarnsdall Company

Contractor

COMPLETED

SECTION PLAT

		0	

330 Ft. from N. Line

_____ Ft. from S. Line

_____ Ft. from E. Line

330 Ft. from W. Line

Location _____

Rig up _____

Drilling and Remarks:

1052 bbl

RECORD

Cased _____ in., _____ ft.

Sand Hutton 3540

Gas _____

Oil _____

Total Depth 3556

PRODUCTION

1st 24 hrs. Nat. _____

1st 24 hrs. after shot _____

Gas _____ Cu. Ft.

Dry Hole _____

Abandoned _____

Date

ORVAL MANNSCHRECK

7-26-37₁₉

Scout

Reno

KANSAS

Map No. 40 Sec. 11 Twp. 23 R. 4WWell No. 1 Sabin "C"Barnsdall

Company

Contractor

FIRST REPORT

NW SE

330 Ft. from N. Line

_____ Ft. from S. Line

_____ Ft. from E. Line

330 Ft. from W. Line

SECTION PLAT

		0	

Location _____

Rig up _____

Drilling and Remarks:

OWDD-OTD 3566

RU

RECORD

Cased _____ in., _____ ft.

Sand _____

Gas _____

Oil _____

Total Depth _____

PRODUCTION

1st 24 hrs. Nat. _____

1st 24 hrs. after shot _____

Gas _____ Cu. Ft.

Dry Hole _____

Abandoned _____

Date

AUG 3 - 1923 19

H. D. Hatfield

Scout

Reno

KANSAS

Map No. 40 Sec. 11 Twp. 23 R. 4WWell No. 1 Sabin "C"Barnsdall

Company

Contractor

COMPLETED

SECTION PLAT

NW SE
330 Ft. from N. Line
 _____ Ft. from S. Line
 _____ Ft. from E. Line
330 Ft. from W. Line

		0	

Location _____

Rig up _____

Drilling and Remarks:

2000 acid
LOT 108
LOTS OF WTR

RECORD

Cased 7 in., 3770 ft.Sand A-1-b 3769

Gas _____

Oil _____

Total Depth 3775

PRODUCTION

1st 24 hrs. Nat. _____

1st 24 hrs. after shot _____

Gas _____ Cu. Ft.

Dry Hole _____

Abandoned _____

Date

AUG 31 1938

19

H. D. Hatfield Scout