

Reno


Form 51-5M-5-34-Palace

Map No. KANSAS Sec. 11 Twp. 23 R. 4W

Well No. 6-C Robin Farm

Barnsdall Company

NORTH

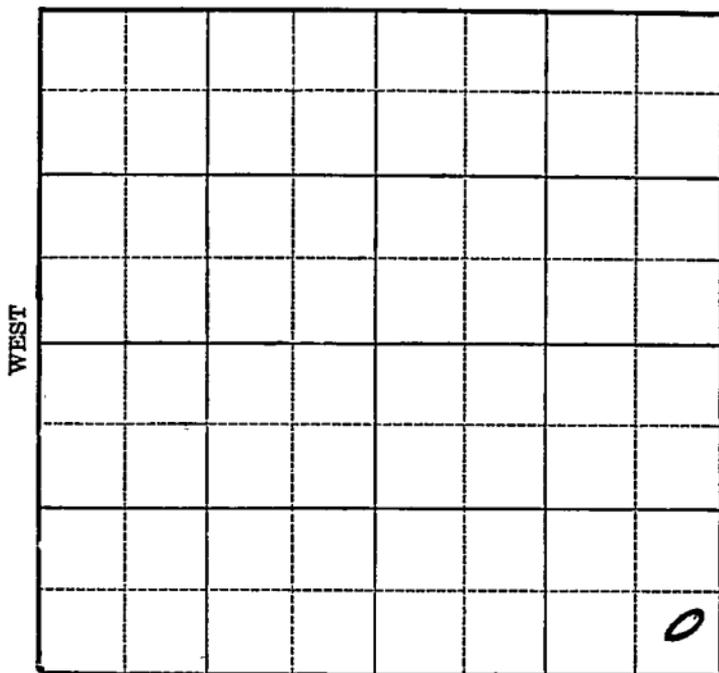

16

SOUTH

Location _____

Drilling Remarks _____

Rig Up _____

Drilling Remarks _____

RECORD

Cased _____ in. _____ ft.

Sand _____

Gas _____

Oil _____

Total Depth _____

PRODUCTION

1st 24 hrs. Nat. _____

1st 24 hrs. after shot _____

Gas _____ cu. ft.

Dry Hole _____


Abandoned _____

Reno

Map No. KANSAS Sec. 11 Twp. 23 R. 4W

Well No. 6-C Sabin Farm
Barnwell Company

_____ Ft. from N. Line
330 Ft. from S. Line
330 Ft. from E. Line
_____ Ft. from W. Line

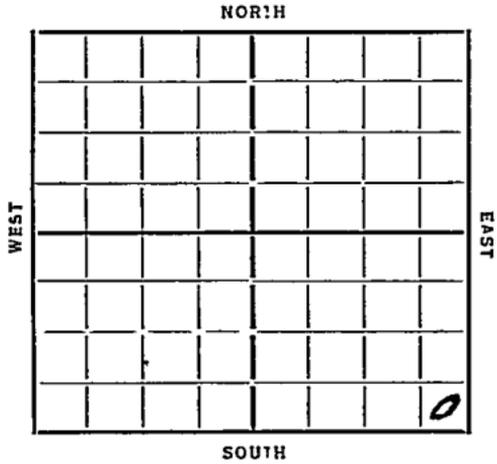

REPORT

Date	Well	Notes
12/24		
12/12	Ponds	
12/21	Rig	
12/27		
1/3/35	Rign	16" 160
1/10	Dlg 800	13" 600
1/17	" 2932	Lausing 2555
1/24	Chat 3460	Huntow 3610
1/31	T D 3621	7" 3609
	P 428 Bbls	1500 acid
2/7	Pot 2118 Bbls	2000 acid
2/13	Huntow 3610	T D 3621
	1500 acid	2000 acid
	2509 Bbls	

COMPLETED

Map No. 40 Sec. 11 Twp. 23 R. 4 W

Well No. 60-Sabin

Barnsdall Company

Contractor

FIRST REPORT SECTION PLAT

..... Ft. from N. Line

330 Ft. from S. Line

330 Ft. from E. Line

..... Ft. from W. Line

			0

Location.....

Rig up.....

Drilling and Remarks:

ponds

RECORD

Cased..... in., ft.

Sand.....

Gas.....

Oil.....

Total Depth.....

PRODUCTION

1st 24 hrs. Nat.....

1st 24 hrs. after shot.....

Gas..... Cu. Ft.

Dry Hole.....

Abandoned.....

Date

12-12-37 192

ORVAL MANNSCHRECK Scout

KANSAS

Map No. 40 Sec. 11 Twp. 23 R. 4W

Well No. 60- Dabin

Barnsdall Company

Contractor

COMPLETED

SECTION PLAT

			0

..... Ft. from N. Line

330 Ft. from S. Line

330 Ft. from E. Line

..... Ft. from W. Line

Location.....

Rig up.....

Drilling and Remarks:

1500 acid
2000 acid

2509 bbb

RECORD

Cased..... in. ft.

Sand Hutton 3610

Gas.....

Oil.....

Total Depth 3621

PRODUCTION

1st 24 hrs. Nat.....

1st 24 hrs. after shot.....

Gas..... Cu. Ft.

Dry Hole.....

Abandoned.....

Date

2-13-35 192.....

ORVAL MANNSCHRECK

Scout