

Reno


Form 51-5M-5-34-Palace

Map No. KANSAS Sec. 11 Twp. 23 R. 4W

Well No. #6B ~~to C~~ Sabin Farm

Barnedill Oil Company

NORTH

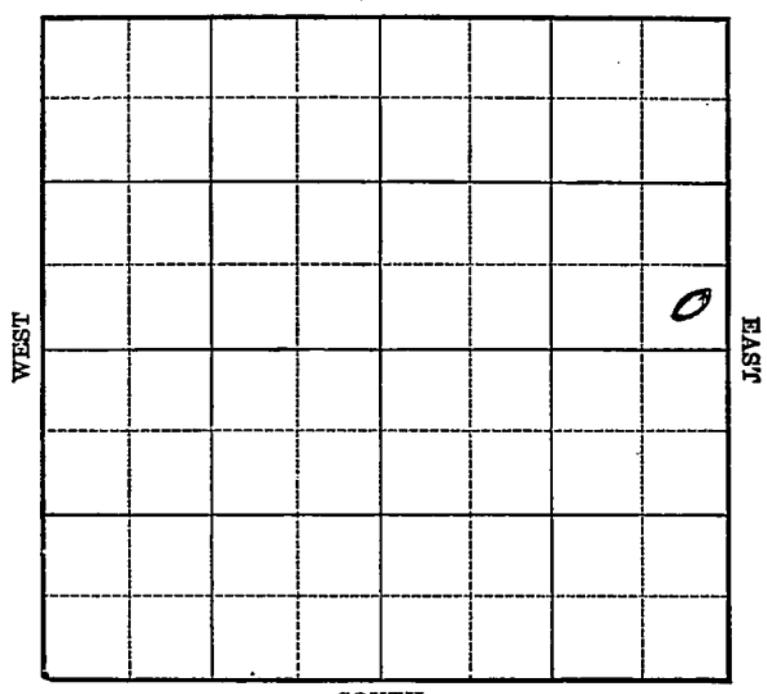

SOUTH

Location \_\_\_\_\_

Drilling Remarks \_\_\_\_\_

\_\_\_\_\_

\_\_\_\_\_

Rig Up \_\_\_\_\_

Drilling Remarks \_\_\_\_\_

\_\_\_\_\_

\_\_\_\_\_

**RECORD**

Cased \_\_\_\_\_ in. \_\_\_\_\_ ft.

Sand \_\_\_\_\_

Gas \_\_\_\_\_

Oil \_\_\_\_\_

Total Depth \_\_\_\_\_

**PRODUCTION**

1st 24 hrs. Nat. \_\_\_\_\_

1st 24 hrs. after shot \_\_\_\_\_

Gas \_\_\_\_\_ cu. ft.

Dry Hole \_\_\_\_\_

Abandoned \_\_\_\_\_

Reno


Map No. KANSAS Sec. 11 Twp. 23 R. 4 W  
Well No. 6-BX Robin Farm \_\_\_\_\_  
Barnsdall Oil Company

\_\_\_\_\_ Ft. from N. Line

330 Ft. from S. Line

330 Ft. from E. Line

\_\_\_\_\_ Ft. from W. Line

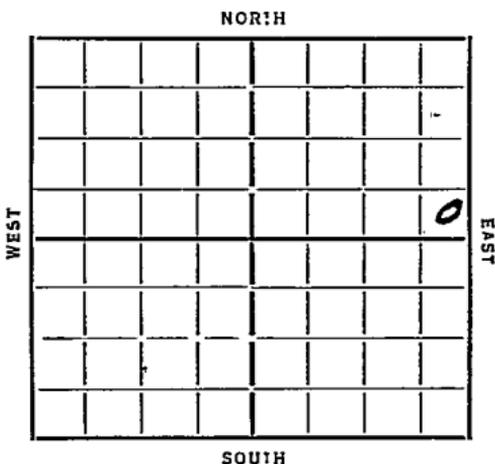

Date 1934 REPORT

12/5 Cellar  
12/27 Dlg 1158  
1/3/35 2620  
1/10 Chrt 3265 199ML 3505  
Henton 3607 TD 3612  
prep run 7"  
1/16 Henton 3611 TD 3671  
1000 acid 1693 Bbls.

COMPLETED

Map No. 40 Sec. 11 Twp. 23 R. 4W

Well No. 6E-Sabin

Barnsdall Oil Company

Contractor

**FIRST REPORTS**

.....Ft. from N. Line

330 Ft. from S. Line

330 Ft. from E. Line

.....Ft. from W. Line

**SECTION PLAT**

			0

Location.....

Rig up.....

Drilling and Remarks:

*cellar*

**RECORD**

Cased.....in., .....ft.

Sand.....

Gas.....

Oil.....

Total Depth.....

**PRODUCTION**

1st 24 hrs. Nat.....

1st 24 hrs. after shot.....

Gas.....Cu. Ft.

Dry Hole.....

Abandoned.....

Date

12-5-37 192.....

**ORVAL MANNSCHRECK**

Scout

Map No. 40 Sec. 11 Twp. 23 R. 4W

Well No. 6B-Sabin

Barnsdall oil Company

Contractor

**CORRECTION**

**SECTION PLAT**

.....Ft. from N. Line

330 Ft. from S. Line

330 Ft. from E. Line

.....Ft. from W. Line

			○

**CORRECTION**

Location.....

Rig up.....

Drilling and Remarks:

*correct  
from 6C  
to above*

**RECORD**

Cased.....in., .....ft.

Sand.....

Gas.....

Oil.....

Total Depth.....

**PRODUCTION**

1st 24 hrs. Nat.....

1st 24 hrs. after shot.....

Gas.....Cu. Ft.

Dry Hole.....

Abandoned.....

Date

12-15-37 192

*Oval Mansfield*

Map No. 40 Sec. 11 Twp. 23 R. 4W

Well No. 6B - Robin

Barnsdall Company

Contractor

**COMPLETED**

SECTION PLAT

..... Ft. from N. Line

330 Ft. from S. Line

330 Ft. from E. Line

..... Ft. from W. Line

			0

Location.....

Rig up.....

Drilling and Remarks:

1000 acid

1693 hpb

RECORD

Cased..... in., ..... ft.

Sand Hunter 3611

Gas.....

Oil.....

Total Depth 3621

PRODUCTION

1st 24 hrs. Nat.....

1st 24 hrs. after shot.....

Gas..... Cu. Ft.

Dry Hole.....

Abandoned.....

Date

1-16-35 192.....

**ORVAL MANNSCHECK**

Scout