

Map No. **KANSAS** Sec. **11** Twp. **23** R. **4W**
 Well No. **11-B Robin** Farm
Barnes Oil Company

NORTH

WEST

EAST

SOUTH

Location

Drilling Remarks

Rig Up

Drilling Remarks

RECORD

Cased _____ in. _____ ft.

Sand _____

Gas _____

Oil _____

Total Depth _____

PRODUCTION

1st 24 hrs. Nat. _____

1st 24 hrs. after shot _____

Gas _____ cu. ft.


Dry Hole _____

Abandoned _____

Reno

Map No. KANSAS Sec. 11 Twp. 23 R. 4W
Well No. 11-B Robin Farm
Barnsdall Company

 Ft. from N. Line
990 Ft. from S. Line
 Ft. from E. Line
990 Ft. from W. Line

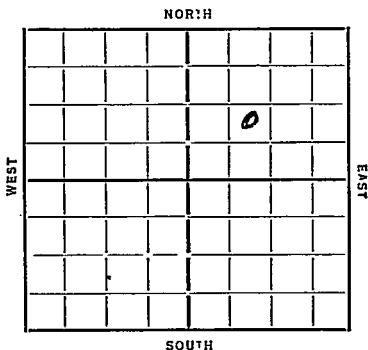

Date

REPORT

1935
3/27 Cellar
4/4 Rur
4/11 dlg 840 16" 240
4/18 2534 Recem 13
4/26 BL 3470 T.H. 3579
 T7 3586 8578 3578
5/2 1000 acid T7 3586 1/2
5/8 Huntou 3579 T7 3586
 1000 acid 1180 Bbls.

COMPLETED

Map No. 40 Sec. 11 Twp. 23 R. 4WWell No. 11B-SabinBarnsdall oil Company

Contractor

FIRST REPORT

SECTION PLAT

Ft. from N. Line

990 Ft. from S. Line

Ft. from E. Line

990 Ft. from W. Line

		0	

Location.....

Rig up.....

Drilling and Remarks:

cellar

RECORD

Cased.....in.,ft.

Sand.....

Gas.....

Oil.....

Total Depth.....

PRODUCTION

1st 24 hrs. Nat.....

1st 24 hrs. after shot.....

Gas.....Cu. Ft.

Dry Hole.....

Abandoned.....

Date

3-27-35 192.....ORVAL MANNSCHRECK
Scout

KANSAS

Form 26-1M Bks. 528

Map No. 40 Sec. 11 Twp. 23 R. 4WWell No. 11B- RobinBarnsdall Company

Contractor

COMPLETED

SECTION PLAT

		0	

Ft. from N. Line

990 Ft. from S. Line

Ft. from E. Line

990 Ft. from W. Line

Location

Rig up

Drilling and Remarks:

1000 acid

1180 lbs

RECORD

Cased in, ft.

Sand Hutton 3579

Gas

Oil

Total Depth 3586

PRODUCTION

1st 24 hrs. Nat.

1st 24 hrs. after shot

Gas Cu. Ft.

Dry Hole

Abandoned

Date

ORVAL MANNSCHRECK

5-8-38 192 Scout