


Reno

Map No. KANSAS Sec. 11 Twp. 23 R. 4W

Well No. 3-C Robin Farm
Barnsdall Company

330 Ft. from N. Line
____ Ft. from S. Line
330 Ft. from E. Line
____ Ft. from W. Line

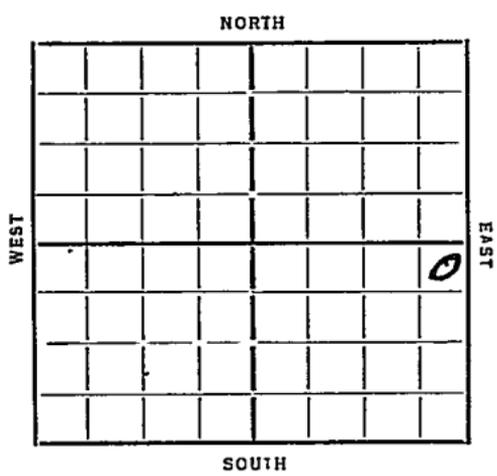

Date	REPORT
10/17	Cellar
10/25	Rig
11/1	11/8 — 11/15 — 11/22
11/28	Moving in
12/6	15 1/2 151
12/13	600' crooked hole
12/21	Qty 807
12/27	" 2890
1/3/35	" 3410 Chat 3260
1/10	1970L 3505 Chat 3262
	Shenton 3607 1/2 7" 3606
	TJ 3620 acidizing
1/16	Shenton 3607 1/2 TJ 3620
	1000 acid 1591 Bbls.

COMPLETED

Map No. 40 Sec. 11 Twp. 23 R. 4W

Well No. BC-Robin

Barnsdall Company

Contractor

FIRST REPORT SECTION PLAT

330 Ft. from N. Line

_____ Ft. from S. Line

330 Ft. from E. Line

_____ Ft. from W. Line

			0

Location _____

Rig up _____

Drilling and Remarks:

cellar

RECORD

Cased _____ in., _____ ft.

Sand _____

Gas _____

Oil _____

Total Depth _____

PRODUCTION

1st 24 hrs. Nat. _____

1st 24 hrs. after shot _____

Gas _____ Cu. Ft.

Dry Hole _____

Abandoned _____

Date

10-17-37 19

ORVAL MANNSCHECK

Scout

Map No. 40 Sec. 11 Twp. 23 R. 44

Well No. 30- Sabin

Barnsdall oil Company

Contractor

COMPLETED

SECTION PLAT

			0

330 Ft. from N. Line

..... Ft. from S. Line

330 Ft. from E. Line

..... Ft. from W. Line

Location.....

Rig up.....

Drilling and Remarks:

1000 acid

1591 bbls

RECORD

Cased..... in., ft.

Sand Hunton 3607 1/2

Gas.....

Oil.....

Total Depth 3620

PRODUCTION

1st 24 hrs. Nat.....

1st 24 hrs. after shot.....

Gas..... Cu. Ft.

Dry Hole.....

Abandoned.....

Date

1-16-35 192

ORVAL MANNSCHRECK

Scout