


Leuo

Form 51-5M-5-34-Palace

Map No. **KANSAS** Sec. *11* Twp. *23* R. *4W*

Well No. *5-C Robin* Farm
Barnsdall Company

NORTH

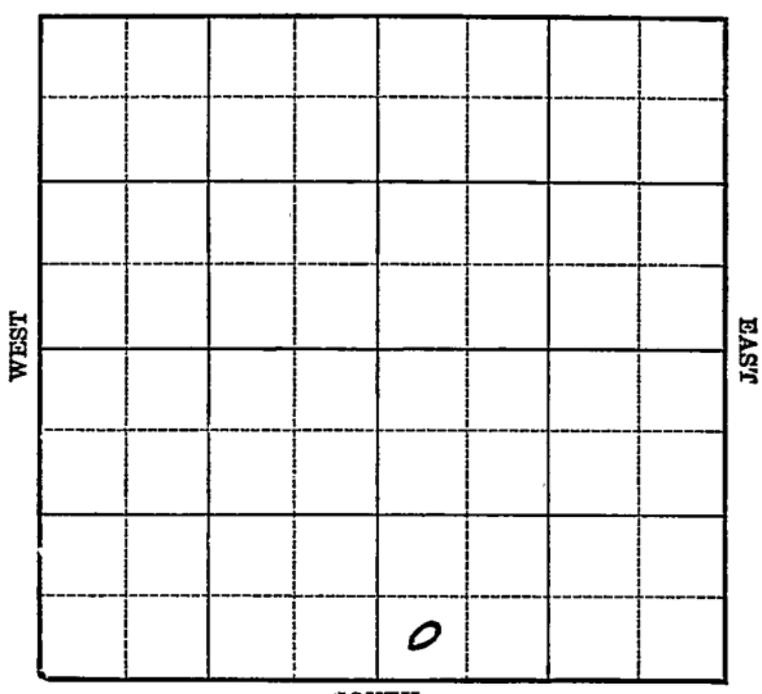

SOUTH

Location _____

Drilling Remarks _____

Rig Up _____

Drilling Remarks _____

RECORD

Cased _____ in. _____ ft.

Sand _____

Gas _____

Oil _____

Total Depth _____

PRODUCTION

1st 24 hrs. Nat. _____

1st 24 hrs. after shot _____

Gas _____ cu. ft.

Dry Hole _____

Abandoned _____

Reno

Map No. KANSAS Sec. 11 Twp. 23 R. 4W


Well No. 5-C Robin Farm
Barnsdell Company

_____ Ft. from N. Line

330 Ft. from S. Line

_____ Ft. from E. Line

330 Ft. from W. Line

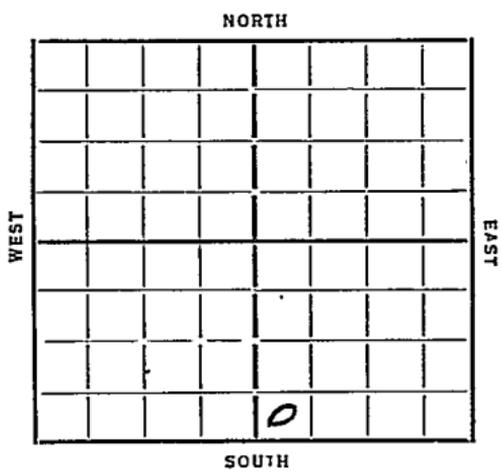

Date 1934

REPORT

<u>11/27</u>	<u>Moving in</u>		
<u>12/6</u>	<u>Qty 430</u>	<u>15 1/2</u>	<u>159</u>
<u>12/18</u>	<u>" 2068</u>	<u>12 1/2</u>	<u>596</u>
<u>12/21</u>	<u>" 2991</u>		
<u>12/27</u>	<u>Shenton 3592 Coring</u>		
<u>1/3/35</u>	<u>8" 3592 B. Shenton 3602 1/2</u>		
	<u>T 3603 1/2 2500' oil 7 hrs.</u>		
<u>1/9</u>	<u>Shenton 3592 T 3603 1/2</u>		
	<u>2000 Gal acid 1870 Bbls.</u>		

COMPLETED

Map No. 40 Sec. 11 Twp. 23 R. 4W

Well No. 5c- Sabin

Barnsdall Company

Contractor

FIRST REPORTS

..... Ft. from N. Line

330 Ft. from S. Line

..... Ft. from E. Line

330 Ft. from W. Line

SECTION PLAT

		0	

Location.....

Rig up.....

Drilling and Remarks:

Moving in

RECORD

Cased..... in., ft.

Sand.....

Gas.....

Oil.....

Total Depth.....

PRODUCTION

1st 24 hrs. Nat.....

1st 24 hrs. after shot.....

Gas..... Cu. Ft.

Dry Hole.....

Abandoned.....

Date

11-27-37 192.....

ORVAL MANNSCHRECK

Scout

Map No. 40 Sec. 11 Twp. 23 R. 4W

Well No. 5C-Sabin

Barnsdall Company

Contractor

COMPLETED

SECTION PLAT

..... Ft. from N. Line

330 Ft. from S. Line

..... Ft. from E. Line

330 Ft. from W. Line

Location.....

Rig up.....

Drilling and Remarks:

2000 acid

1820 lbs.

RECORD

Cased..... in., ft.

Sand Hunter 3592

Gas.....

Oil.....

Total Depth 3603 1/2

PRODUCTION

1st 24 hrs. Nat.....

1st 24 hrs. after shot.....

Gas..... Cu. Ft.

Dry Hole.....

Abandoned.....

Date

1-9-35 192.....

ORVAL MANNSCHRECK
Scout