

Map No. KANSAS Sec. 11 Twp. 23 R. 40
Well No. 8-C Sabine Farm
Barnsdall Oil Company

Well No.

T
Tobin

Farm

Barnsdall oil

Company

NORTH

TEST

PLATE

SOUTH

Location_____

Drilling Remarks

Rig Up

Drilling Remarks

RECORD

Cased_____in. _____ft.

Sand.

Gas.

Oil.

Total Depth

PRODUCTION

1st 24 hrs. Nat.

1st 24 hrs. after shot.

Gas _____ cu. ft.

Dry Hole.

Abandoned


Reno

Map No. KANSAS Sec. 11 Twp. 23 R. 4W

Well No. 8-C Robin Farm

Barusshell Oil Company

NORTH

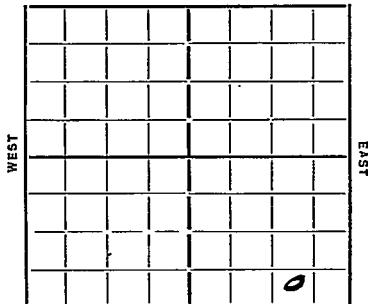

SOUTH

 Ft. from N. Line

330 Ft. from S. Line

990 Ft. from E. Line

 Ft. from W. Line

Date 1/25

REPORT

<u>1/7</u>	<u>Location</u>	
<u>1/10</u>	<u>Cellar</u>	<u>16" 151</u>
<u>1/17</u>	<u>Rig</u>	<u>13" 596</u>
<u>1/24</u>	<u>Rig 600</u>	
<u>1/31</u>	<u>" 2550</u>	
<u>2/7</u>	<u>" 3460</u>	<u>Chat 3258</u>
<u>2/14</u>	<u>Shenton 3589</u>	<u>8578 3589</u>
	<u>T 7 3604</u>	<u>114 oil 892W 15 hrs</u>
<u>2/20</u>	<u>Shenton 3589</u>	<u>T 7 3607</u>
	<u>1107 oil</u>	<u>400 Water.</u>

COMPLETED

KANSAS

Map No. 40 Sec. 11 Twp. 23 R. 4WWell No. 8C-SabinBarnsdall Oil Company

Contractor

FIRST REPORTS

SECTION PLAT

Ft. from N. Line

330 Ft. from S. Line990 Ft. from E. Line

Ft. from W. Line

			0

Location ✓

Rig up

Drilling and Remarks:

RECORD

Cased in., ft.Sand Gas Oil Total Depth

PRODUCTION

1st 24 hrs. Nat. 1st 24 hrs. after shot Gas Cu. Ft.Dry Hole Abandoned

Date

1-2-35 192 O. Mannschreck Scout

Map No. 40 Sec. 11 Twp. 23 R. 4W

Well No. 8C- Sabin

Barnshall oil Company

Contractor

COMPLETED

SECTION PLAT

			0

Ft. from N. Line

330 Ft. from S. Line

990 Ft. from E. Line

Ft. from W. Line

Location

Rig up

Drilling and Remarks:

1107 oil
400 water

RECORD

Cased in. ft.

Sand Huntton 3589

Gas

Oil

Total Depth 3607

PRODUCTION

1st 24 hrs. Nat.

1st 24 hrs. after shot

Gas Cu. Ft.

Dry Hole

Abandoned

Date

ORVAL MANNISCHRECK

2-20-35 192

Scout