



*Revo*

Map No. \_\_\_\_\_ Sec. 11 Twp. 23 R. 40


Well No. #11-C Sabin Farm \_\_\_\_\_  
Barnsdell Company \_\_\_\_\_

990 Ft. from N. Line

\_\_\_\_\_ Ft. from S. Line

330 Ft. from E. Line

\_\_\_\_\_ Ft. from W. Line

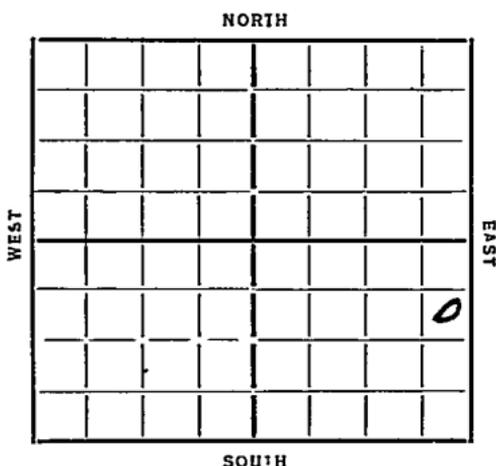

Date 1935

REPORT

2/13 Bldg Rig  
2/21 Rig  
2/28 16" 242 WOC  
3/7 Bldg 1095 17 1/2 749  
3/14 " 3075  
3/21 TC 3268 Huntou 3612  
3/28 7" 3611 T7 3615 1/2 Tak. pot.  
4/3 Huntou 3612 T7 3615 1/2  
 1000 acid 572 Bble.

COMPLETED

Map No. 40 Sec. 11 Twp. 23 R. 4<sup>W</sup>

Well No. 11C - Sabin

Barnsdall oil Company

Contractor

**FIRST REPORTS**

**SECTION PLAT**

990 Ft. from N. Line

..... Ft. from S. Line

330 Ft. from E. Line

..... Ft. from W. Line

**KANSAS**

			o

Location.....

Rig up.....

Drilling and Remarks:

*Bed Rig*

**RECORD**

Cased.....in., .....ft.

Sand.....

Gas.....

Oil.....

Total Depth.....

**PRODUCTION**

1st 24 hrs. Nat.....

1st 24 hrs. after shot.....

Gas.....Cu. Ft.

Dry Hole.....

Abandoned.....

Date

2-13-35 192

**ORVAL MANNSCHECK**

Scout

Map No. 40 Sec. 11 Twp. 23 R. 4W

Well No. 11C - Robin

Barnsdall Oil Company

Contractor

**COMPLETED**

SECTION PLAT

990 Ft. from N. Line

..... Ft. from S. Line

330 Ft. from E. Line

..... Ft. from W. Line

			0

Location.....

Rig up.....

Drilling and Remarks:

1000 acid

572 lbs

RECORD

Cased..... in, ..... ft.

Sand Hanton 3612

Gas.....

Oil.....

Total Depth 3615 1/2

PRODUCTION

1st 24 hrs. Nat.....

1st 24 hrs. after shot.....

Gas..... Cu. Ft.

Dry Hole.....

Abandoned.....

Date

4-3-35 192.....

**ORVAL MANNSCHRECK**

Scout