


Revo

Form 51-5M-5-34-Palace

Map No. **KANSAS** Sec. 11 Twp. 23 R. 4W

Well No. 14-C Robin Farm
Barnsdell Oil Company

NORTH

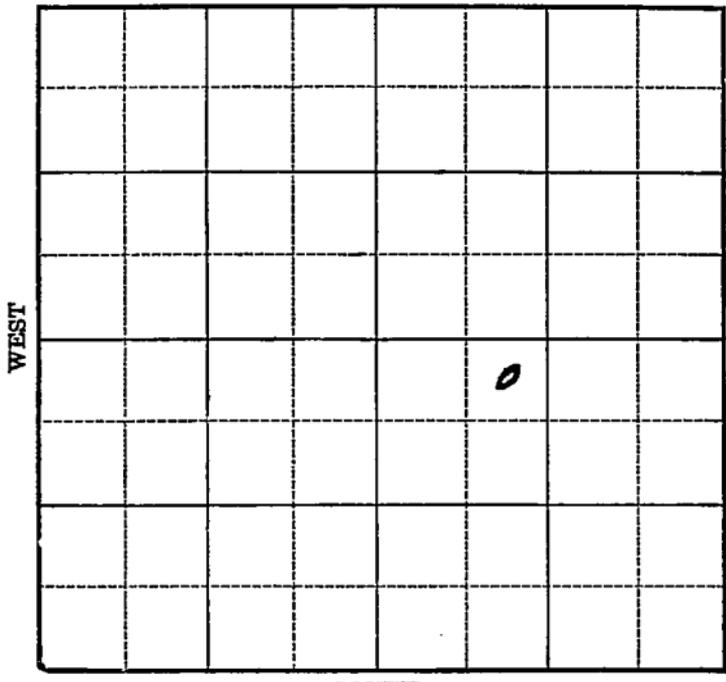

10

Location _____

Drilling Remarks _____

Rig Up _____

Drilling Remarks _____

RECORD

Cased _____ in. _____ ft.

Sand _____

Gas _____

Oil _____

Total Depth _____

PRODUCTION

1st 24 hrs. Nat. _____

1st 24 hrs. after shot _____

Gas _____ cu. ft.

Dry Hole _____

Abandoned _____


Reno

Form 252-A
5M 7-34 MPC

Map No. KANSAS Sec. 11 Twp. 23 R. 4W

Well No. 14-C Sabin Farm
Barusdall Company

330 Ft. from N. Line
____ Ft. from S. Line
____ Ft. from E. Line
990 Ft. from W. Line

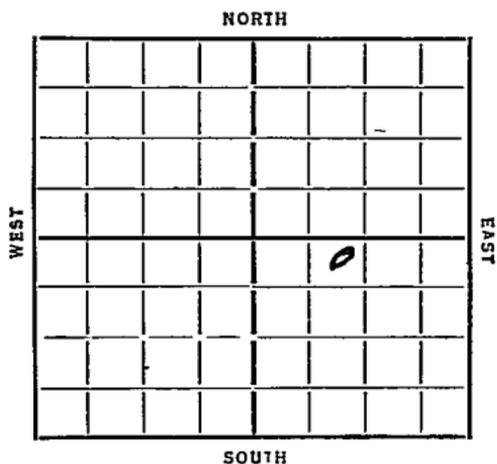

Date

REPORT

1935
3/6 Bldg.
3/14 15" 240 WOC
3/21 Bldg 2530
3/28 Chat 3245 Coring 3555
4/4 BL 3450 T14 3562
878 3561 T17 3568 63 Bbls P/H
4/10 Hunter 3562 T17 3568
 1005 Bbls Nat.
 1000 acid
 1472 Bbls.

COMPLETED

KANS.

Map No. 40 Sec. 11 Twp. 23 R. 4W

Well No. 14C - Sabin

Barnsdall oil Company

Contractor

FIRST REPORTS

330 Ft. from N. Line

..... Ft. from S. Line

..... Ft. from E. Line

990 Ft. from W. Line

SECTION PLAT

		o	

Location.....

Rig up.....

Drilling and Remarks:

Blodg

RECORD

Cased..... in., ft.

Sand.....

Gas.....

Oil.....

Total Depth.....

PRODUCTION

1st 24 hrs. Nat.....

1st 24 hrs. after shot.....

Gas..... Cu. Ft.

Dry Hole.....

Abandoned.....

Date

3-6-35 192.....

ORVAL MANNSCHRECK

Scout

Map No. 40 Sec. 11 Twp. 23 R. 4W

Well No. 14C-Sabin
Barnsdall Company

Contractor

COMPLETED

SECTION PLAT

330 Ft. from N. Line

..... Ft. from S. Line

..... Ft. from E. Line

990 Ft. from W. Line

		0	

Location.....

Rig up.....

Drilling and Remarks:

1005 ft Nat.

1000 acid

1472 bbls

RECORD

Cased..... in. ft.

Sand Hunton 3567

Gas.....

Oil.....

Total Depth 3568

PRODUCTION

1st 24 hrs. Nat.....

1st 24 hrs. after shot.....

Gas..... Cu. Ft.

Dry Hole.....

Abandoned.....

Date

4-10-35 192.....

ORVAL MANNSCHECK

Scout