

KANSAS

FORM 51 5M 10-41 PETROL

Reno


Section 11 Township 23 Range 10-W

Well No. #3 Hinshaw "B"

Company Cities Service
Peace Creek Pool

NORTH

WEST

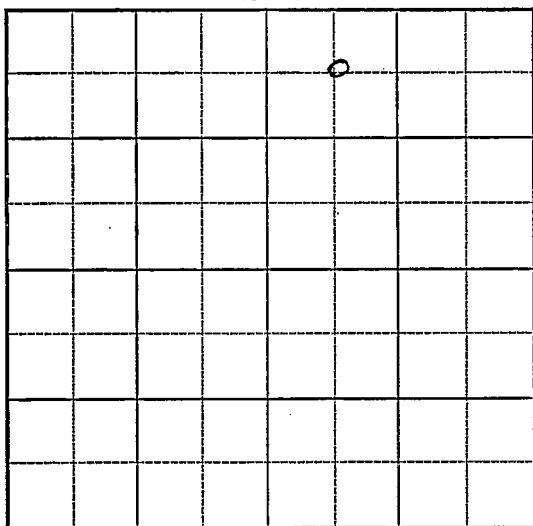

EAST

SOUTH

2

KANSAS Reno

Sec. 11 Twp. 23 R. 10-W

Well No. #3 Hinshaw "B" Farm

Cities Service Oil Company

(Peace Creek Pool)


660 Ft. from N. Line

Ft. from S. Line

Ft. from E. Line

660 Ft. from W. Line

Elev. 1763

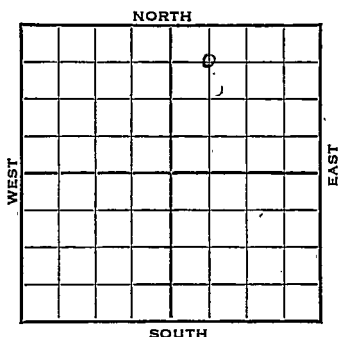

1942

REPORT

7/29

Rotary.

8/5

10" - 167 Drlg. 1455'

8/12

Drlg 3285

8/19

Viola 3757-3769 T.D.

7"

- 3763

RUST

8/27

Viola 3757

7" - 3763

500 acid

Bomb Pot. 3000

T.D. 3770

Gravity 42.

COMPLETED

KANSAS

Reno

Map No. 47 Sec. 11 Twp. 23 R. 10WWell No. 3 Hinshaw "B"Cities Service Oil CompanyFIRST REPORT Contractor

C NW NE

SECTION PLAT

		0	

660 Ft. from N. Line

_____ Ft. from S. Line

_____ Ft. from E. Line

660 Ft. from W. Line

PEACE CREEK POOL

Location _____

Rig up _____

Drilling and Remarks:

Rotary

RECORD

Cased _____ in., _____ ft.

Sand _____

Gas _____

Oil _____

Total Depth _____

PRODUCTION

1st 24 hrs. Nat. _____

1st 24 hrs. after shot _____

Gas _____ Cu. Ft.

Dry Hole _____

Abandoned _____

Date

JUL 29 1942

19

S. J. LEWIS Scout

Map No. 47 Sec. 11 Twp. 23 R. 10WWell No. 3 Hinshaw "B"

Cities Service Oil Company

COMPLETED

Contractor

C NW NE

SECTION PLAT

660 Ft. from N. Line Ft. from S. Line Ft. from E. Line660 Ft. from W. Line

PEACE CREEK POOL

Location Rig up

Drilling and Remarks:

*Viola 3757**7" @ 3763**5000 cu ft**Bone + Pt 8000**42° Gr*

RECORD

Cased in., ft.Sand Gas Oil Total Depth 8770

PRODUCTION

1st 24 hrs. Nat. 1st 24 hrs. after shot Gas Cu. Ft.Dry Hole Abandoned

Date

AUG 27 1942

19

S. J. LEWIS Scout