

KANSAS

Reno


FORM 51 5M 10-41 PETROL

Section 11 Township 23 Range 10-W

Well No. #1 Hinshaw "C"

Company Cities Service Oil

NORTH Peace Creek Pool

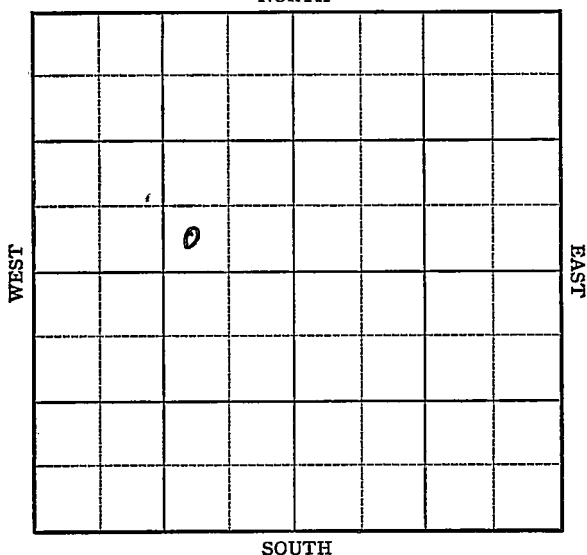

6

Sec. 11 Twp. 23 R. 10-W

Well No. #1 Hinshaw "G" Farm

Cities Service Oil Company

(Peace Creek)


 Ft. from N. Line

330 Ft. from S. Line

990 Ft. from E. Line

 Ft. from W. Line

Elev. 1762

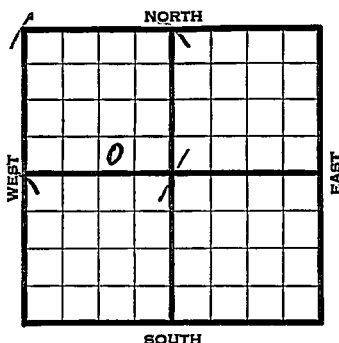

1942

REPORT

4/29

Rotary.

5/6

8" - 258' Drlg. 2221'

5/13

Drlg. 3615'

5/20

Lans. 3270'

Viola 3789'

T.D. 3800'

No shows.


ABANDONED

Ren.o

KANSASMap No. 47 Sec. 11 Twp. 23 R. 10WWell No. 1 Hinshaw "C"Cities Service Oil Company**FIRST REPORT** Contractor

SW SE NW

SECTION PLAT

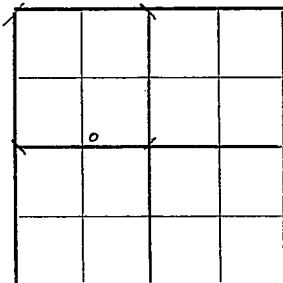 Ft. from N. Line330 Ft. from S. Line990 Ft. from E. Line Ft. from W. Line**PEACE CREEK POOL**Location Rig up

Drilling and Remarks:

Rotary

RECORDCased in., ft.Sand Gas Oil Total Depth **PRODUCTION**1st 24 hrs. Nat. 1st 24 hrs. after shot Gas Cu. Ft.Dry Hole Abandoned

Date

APR 29 1942 19 S. J. LEWIS Scout


Reno

KANSAS

Map No. 47 Sec. 11 Twp. 23 R. 10WWell No. 1 Hinshaw "C"Cities Service Oil CompanyABANDONED Contractor

SW SE NW

SECTION PLAT

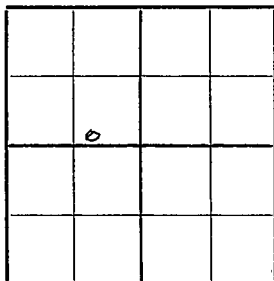 Ft. from N. Line330 Ft. from S. Line990 Ft. from E. Line Ft. from W. Line

PEACE CREEK POOL

Location Rig up

Drilling and Remarks:

*lane 3270**Vista 3789**No show*

RECORD

Cased in., ft.Sand Gas Oil Total Depth 3780

PRODUCTION

1st 24 hrs. Nat. / 1st 24 hrs. after shot Gas Cu. Ft.Dry Hole Abandoned

Date

MAY 20 1942 19 S. J. LEWIS Scout