



Sec. 11 Twp. 23 R. 10-W

Well No. #7 Tonn Farm

Leader Oil Company

(Peace Creek)


         Ft. from N. Line

330 Ft. from S. Line

900 Ft. from E. Line

990 Ft. from W. Line

Elev. 1755

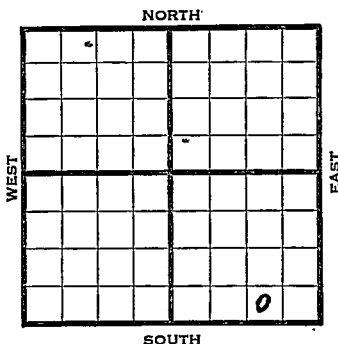

1942

REPORT

3/25 Cellar.

4/2       "

4/8       "

4/15      "

4/22      "

4/29      "

5/6       "

5/13 Drlg. 75'

5/20 10" - 296' Drlg. 2245'

5/27 Drlg. 3377'

6/3 Lans. 3266' Viola 3745' T.D. 3750'

7" - 3750' RUST.

**OVER**

1942

6/10

Viola 3745'

7" - 3750'

T.D. 3755 $\frac{1}{2}$ '

500 acid.

Bomb potential 28,755 bbls.

Maximum ~~bbls~~ 3000 bbls.

42. Gravity

**COMPLETED**

Map No. 47 Sec. 11 Twp. 23 R. 10WWell No. 7 TonnLeader Oil Company**FIRST REPORT** Contractor

SW SE SE

## SECTION PLAT

			o

         Ft. from N. Line330 Ft. from S. Line990 Ft. from E. Line( ) Ft. from W. Line

PEACE CREEK POOL

Location                                 Rig up                                 

Drilling and Remarks:

Cellar

## RECORD

Cased          in.,          ft.Sand                                 Gas                                 Oil                                 Total Depth                         

## PRODUCTION

1st 24 hrs. Nat.                         1st 24 hrs. after shot                         Gas                          Cu. Ft.Dry Hole                         Abandoned                         

Date

MAR 25 1942 19 S. J. LEWIS Scout

Map No. 47 Sec. 11 Twp. 23 R. 10W

Well No. 7 Tonn

Leader Oil Company

**COMPLETED** Contractor

S W S E S E

SECTION PLAT

\_\_\_\_\_ Ft. from N. Line

330 Ft. from S. Line

990 Ft. from E. Line

\_\_\_\_\_ Ft. from W. Line


PEACE CREEK POOL

Location \_\_\_\_\_

Rig up \_\_\_\_\_

Drilling and Remarks:

*V. D. La 3745.*  
*7" C 3750.*  
*500 acid*  
*Born & P 28750*  
*Max 3000*  
*42 2/3*

RECORD

Cased \_\_\_\_\_ in., \_\_\_\_\_ ft.

Sand \_\_\_\_\_

Gas \_\_\_\_\_

Oil \_\_\_\_\_

Total Depth 3755 1/2

PRODUCTION

1st 24 hrs. Nat. \_\_\_\_\_

1st 24 hrs. after shot \_\_\_\_\_

Gas \_\_\_\_\_ Cu. Ft.

Dry Hole \_\_\_\_\_

Abandoned \_\_\_\_\_

Date

JUN 10 1942

19

S. J. LEWIS

Scout