

KANSAS

FORM 51 5M 4-41 PETROL

Reno

Section 11 Township 23 Range 10-W

Well No. #8 Tonn

Company Leader

NORTH Peace Creek Pool

10

0

SOUTH

Sec. 11 Twp. 23 R. 10-WWell No. #8 Tonn Farm


Leader

Company

(Peace Creek)

990 Ft. from N. Line Ft. from S. Line Ft. from E. Line330 Ft. from W. Line

Elev. 1760

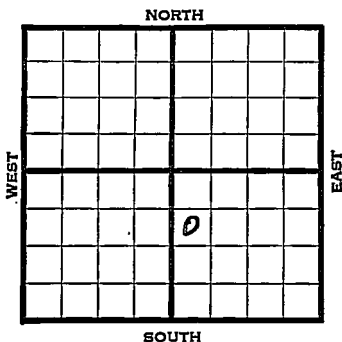

1942

REPORT

5/20

Derrick.

5/27

"

6/3

Drlg. 250'

6/10

10" - 300' Drlg. 2820'

6/17

Drlg. 3683'

6/24

Viola 3753-57' T.D. 5" - 3756' RUST.

7/1

T.D. 3759' 1800' oil 4 hours.

500 acid. Flow 50 oil 3/4 hours.

7/8

Viola 3753'

5" - 3756'

T.D. 3759'

500 acid.

Bomb potential 15,230 bbls.

Maximum 3000 bbls.

42. Gravity

COMPLETED

Reno

KANSAS

Map No. 47 Sec. 11 Twp. 23 R. 10WWell No. 8 Tonn _____

Leader _____

Company _____

FIRST REPORT

Contractor _____

SW NW SE

990 Ft. from N. Line

_____ Ft. from S. Line

_____ Ft. from E. Line

330 Ft. from W. Line

SECTION PLAT

		o	

PEACE CREEK POOL

Location _____

Rig up _____

Drilling and Remarks:

Derrick

RECORD

Cased _____ in., _____ ft.

Sand _____

Gas _____

Oil _____

Total Depth _____

PRODUCTION

1st 24 hrs. Nat. _____

1st 24 hrs. after shot _____

Gas _____ Cu. Ft.

Dry Hole _____

Abandoned _____

Date

MAY 20 1942S. J. LEWIS Scout

Reno

KANSAS

Map No. 47 Sec. 11 Twp. 23 R. 10WWell No. 8 Tonn

Leader

Company

COMPLETED

Contractor

SW NW SE

SECTION PLAT

		6	

990 Ft. from N. Line Ft. from S. Line Ft. from E. Line330 Ft. from W. Line

PEACE CREEK POOL

Location

Rig up

Drilling and Remarks:

Vidla 8759
5' @ 37.56
500 acid
Boil & PT 15230
Max 3000'
42 @ 92

RECORD

Cased in., ft.

Sand

Gas

Oil

Total Depth 8759

PRODUCTION

1st 24 hrs. Nat. 1st 24 hrs. after shot Gas Cu. Ft.

Dry Hole

Abandoned

Date

JUL 8 1942 19

S. J. LEWIS

Scout