


Section 11 Township 23 Range 10-W

Well No. #9 Tonn

Company Leader Oil

NORTH Peace Creek Pool

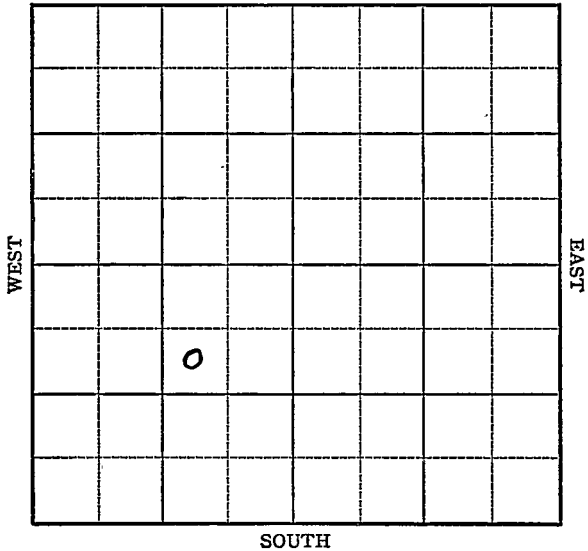


Sec. 11 Twp. 23 R. 10-WWell No. #9 Tonn FarmLeader Oil Company

(Peace Creek)

990 Ft. from N. Line Ft. from S. Line990 Ft. from E. Line Ft. from W. Line

Elev. 1760

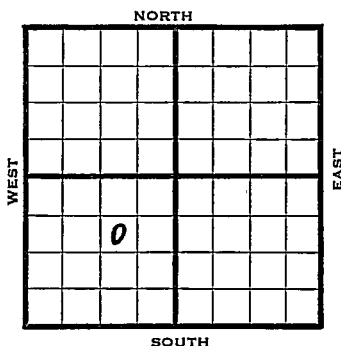

1942

REPORT

7/1 Pits.
7/8 10" - 300' Drlg. 1665'
7/15. Drlg. 3016'
7/22 Misenar 3753 Viola 3744
7" @ 3757 RUST
7/29 " " "
8/5 T.D. 3764 $\frac{1}{2}$ HFO
500 acid
Flow 30 oil per hr 8 hrs.
8/12 Viola 3755
7" - 3757
T.D. 3764 $\frac{1}{2}$
500 acid
Bomb Pot. 12,174
Max. 3000
Gravity 42.

COMPLETED

Re no

KANSAS

Map No. 47 Sec. 11 Twp. 23 R. 10WWell No. 9 Tonn

Leader Oil

Company

FIRST REPORT

Contractor

SW NE SW

SECTION PLAT

990 Ft. from N. Line

Ft. from S. Line

990 Ft. from E. Line

Ft. from W. Line

Peace Creek Pool

Location

Rig up

Drilling and Remarks:

Pits

RECORD

Cased _____ in., _____ ft.

Sand _____

Gas _____

Oil _____

Total Depth _____

PRODUCTION

1st 24 hrs. Nat. _____

1st 24 hrs. after shot _____

Gas _____ Cu. Ft.

Dry Hole _____

Abandoned _____

Date

JUL 1 1942 19

S. J. LEWIS

Scout

Map No. 47 Sec. 11 Twp. 23 R. 10WWell No. 9 Tonn

Leader Oil

Company

COMPLETED

Contractor

SECTION PLAT

SW NE SW

990 Ft. from N. Line

Ft. from S. Line

990 Ft. from E. Line

Ft. from W. Line

	0		

PEACE CREEK POOL

Location

Rig up

Drilling and Remarks:

Viola 3755
7" @ 3757
500 cu ft
Bon & P 8/12/74
Wax 3000
42 @ 4

RECORD

Cased _____ in., _____ ft.

Sand _____

Gas _____

Oil _____

Total Depth 3764 1/2

PRODUCTION

1st 24 hrs. Nat. _____

1st 24 hrs. after shot _____

Gas _____ Cu. Ft.

Dry Hole _____

Abandoned _____

Date

AUG 12 1942 19

S. J. LEWIS Scout