


Section 11 Township 23 Range 13 W

Well No. #1 Firebaugh

Company Michaelis Drlg.

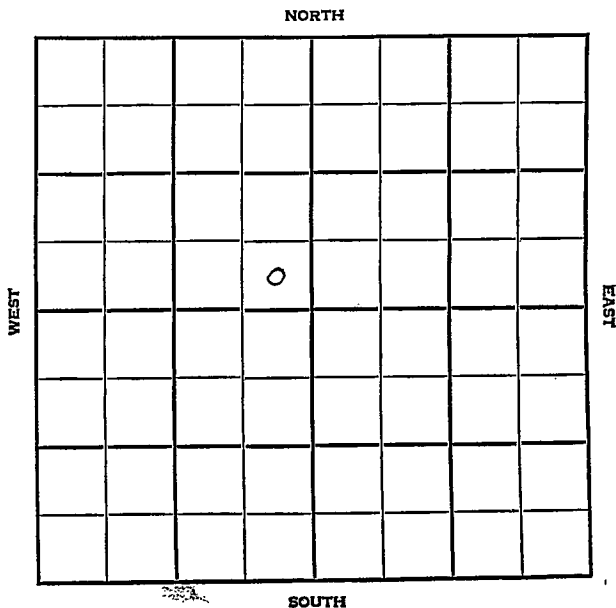

SEC. 11	TWP. 23	R. 13W
------------	------------	-----------

WELL NO.

#1 Firebaugh

FARM

COMPANY

Michaelis Drlg.

CONTRACTOR

Garvey

NE Happy Valley

NORTH

_____ Ft. from N. Line

_____ Ft. from S. Line

_____ Ft. from E. Line

_____ Ft. from W. Line

			0			

WEST

EAST

SOUTH

SE SE NW

1955	ELEVATION 1867'	REPORT
------	--------------------	--------

9-14 Comm. 9-9-55
8" @ 310/200
Drlg. 2070'

~~###~~

12-7 DST 3859-64 op 1 hr. rec. 690' GIP
210' oil, 1230#
5 $\frac{1}{2}$ " @ 3860/100
CO to 3864
B/ 20 gpph, 250 A,
S/ 20 bo 1 hr.
Comp. 28 BOPD, 30% wtr.
H. 3273
BL. 3410
L. 3425
V. 3749
S. 3812
A. 3860
TD 3864'

COMPLETED

County Stafford Elev. _____

Sec. 77 Twp. 23 Rge. 13W

Company Michaelis Drlg.

FarmName Firebaugh No. 1

TOPS	DEPTH	LOG	DATUM
Anh.			
Tp.			
H.			
Tr.			
Dg.			
Bl.			
L.			
K.C.			
B.K.C.			
Ce.			
C.			
M.			
M.			
K.			
Mz.			
Me.			
V.			
S.			
S.			
A.			
R.			
PE.			
G.			
T.D.			

Loc. in Sec. _____

SE SE NW

Geol. _____

Contr. _____

Garvey

Pool _____

NE Happy Valley

	SEP 4 '55	
	0	
FIRST REPORT		

Date Comm. 9-9-55

8" @ 310/200 drlg. 2070

3

Co.
Lse.
FNo.
Sec.
T.
R.

County Stafford Elev. 1867
 Sec. 11 Twp. 23 Rge. 13W
 Company Michaelis Drlg.
 Farm Name Firebaugh No. 1

TOPS	DEPTH	LOG	DATUM
Anh.			
Tp.			
H.	<u>3273</u>		<u>1406</u>
Tr.			
Dg.			
Bl.	<u>3410</u>		<u>1543</u>
L.	<u>3425</u>		<u>1558</u>
K.C.			
B.K.C.			
Ce.			
C.			
M.			
M.			
K.			
Mz.			
Me.			
V.	<u>3749</u>		<u>1882</u>
S.	<u>3812</u>		<u>1945</u>
S.			
A	<u>3860</u>		<u>1993</u>
R.			
PE.			
G.			
TD.	<u>3864</u>		

Loc. in Sec. _____

SE SE NW

Geol. _____

Contr. _____

Garvey

Pool _____

NW Happy Valle

COMPLETED			
		0	

Date Comm. 9-9-55

DEC 7 1955

8" @ 310/200 DST 3859-64 open 1 hr.

rec. 690' GIP 210' oil 1230#

5 1/2" @ 3860/100 CO to 3864 B/ 20 goph

250 A S/ 20 bo 1 hr.

Comp. 28 bopd 30% wtr.