


Section 11 Township 23 Range 13THWell No. 1 WardCompany Oil Capitol Corp.

NORTH

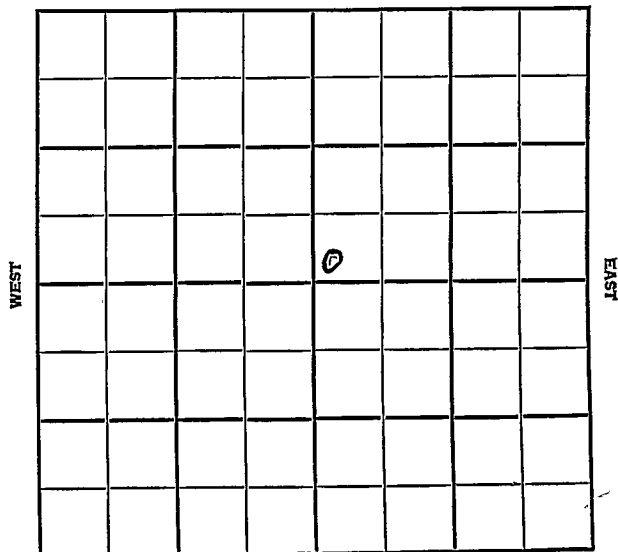

SOUTH

SEC.	TWP.	R.
11	23	13 W

WELL NO.

1 Ward

FARM

COMPANY

Oil Capitol Corp.

CONTRACTOR

Iron Drlg.

Wildcat


Ft. from N. Line

Ft. from S. Line

Ft. from E. Line

Ft. from W. Line

SW SW NE

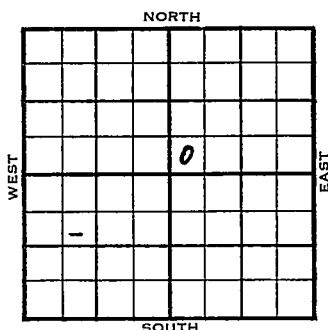

1/2 Mile - SDX

	ELEVATION	REPORT
1955	1863' KB	
6/22	MIR	-
6/30	Spud 6-23-55, 8 5/8" @ 295/200, Anhy. 735, drlg. 2735.	
7/7	Heeb 3260', read 3296', Br. lime 3398' Lans. 3418', Viola 3728', Simp. 3789' Arb. 3855' TD 3869' DST 3434-3505, open 1 hr rec 125' muddy SW, 1030/20" DST 3544-50, open 35 min, rec 20' mud spk. oil DST 3559-3604, open 1 hr rec 125' mud 830# DST 3792-3826, open 1 hr rec 2230' SW, 11400# DST 3857-67, open 1 hr rec 360' gas, 1080' oil, 1270#. 5 1/2" @ 3857 WOCT	
7/14	CO to 3867, FU 1100' oil, S/6 boph, 10 hr. rang. tubing.	
7/22	Putting on pump	
7/28	P/10 bo 1 hr. no wtr.	
8/4	No report	
8/11	Noreport	
8-25	No report	

1955

8/31 Comm 6/23/55

Anh 735

H 3260

Tr oviad 3296

BL 3398

L 3418

V 3728

S 3789

A 3855

TD 3867 3869

8 5/8" @ 295 w/200

DST 3434-3505 open 1 hr

Rec 125' mdy sw FP 50-1005

BHP 1030# 20" DST 3544-50 open 35"

Rec 20# M Spe oil no BHP

DST 3559-3604 open 1 hr Rec 125'

md BHP 330

DST 3792-3826 open 1 hr Rec 2230'

sw FP 170-1100 BHP 1400

DST 3857-67 open 1 hr Rec 360' gas

plus 1080' oil FP 120-330 BHP 1270

5 1/2 3857 WOCT FU 1100' oil no wtr

no time Swb 6 boph no wtr for 19 hrs 2'

2700' from surf. P 10 bo in 1 hr

no wtr est gr 35 deg.

P 147 BO plus 6% wtr gr 30.6

Arb 3857-67

COMPLETED

County Stafford Elev. _____
 Sec. 11 Twp. 23 Rge. 13W
 Company Oil Capitol Corp.
 Farm Name Ward No. 1

TOPS

DEPTH

LOG

DATUM

Loc. in Sec. _____

Anh.

Tp.

H.

Tr.

Dg.

BL.

L.

K.C.

B.K.C.

Ce.

C.

M.

M.

K.

Mz.

Me.

V.

S.

S.

A.

R.

P.E.

G.

T.D.

SW SW NE

Geol. _____

Contr. _____

Iron Drlg.

Pool

Wildcat

JUN 22 '55

0

1/2 mile

FIRST REPORT

Date Comm. _____

M T R

County Stafford Elev. 1863 KBSec. 14 Twp. 23S Rge. 13WCompany Oil Capitol Corp.Farm Name Ward No. 1

TOPS

DEPTH

LOG

DATUM

Loc. in Sec.

Anh.

735

SW SW NE

Tp.

H.

Tr. orlad

Dg.

BL.

L.

K.C.

B.K.C.

Ce.

C.

M.

M.

K.

Mz.

Ma.

V.

S.

S.

A.

R.

PE.

G.

T.D.

32601397329614333398153534181555Geol. Tomlinson

Contr.

Iron Drlg.

Pool

Happy Valley

372818653789192638551992

COMPLETE

Date Comm. 6/23/55 AUG 31 1955

8 5/8" 295-w/200 DST 3434-3505 open 1 hr

Rec. 125' mdy sw FP 50-1005 BHP 1030#

20" DST 3544-50 open 35" Rec. 20# m spe oil

no BHP DST 3559-3604 open 1 hr. Rec. 125'

Md BHP 330 DST 3792-3826 open 1 hr.


Rec. 2230' sw FP 170-1100 BHP 1400

DST 3857-67 open 1 hr Rec. 360' gas plus

1080' oil FP 120-330 BHP 1270

OVER

5 1/2 3857 WOCT FU 1100' oil no wtr no time
Swb 6 boph no wtr for 19 hrs 2700' from surf.
P 10 bo in 1 hr no wtr est gr 35°
P 147 bo plus 6% wtr gr. 30.6
Arb 3857-67

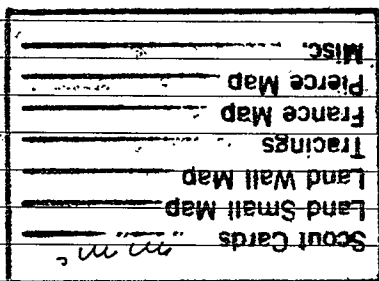

SEP 8 1955