


KANSAS

Section 11 Township 23 Range 11W

Well No. #1 Miller

Company Natural Gas & Oil & Rep. Nat. Gas

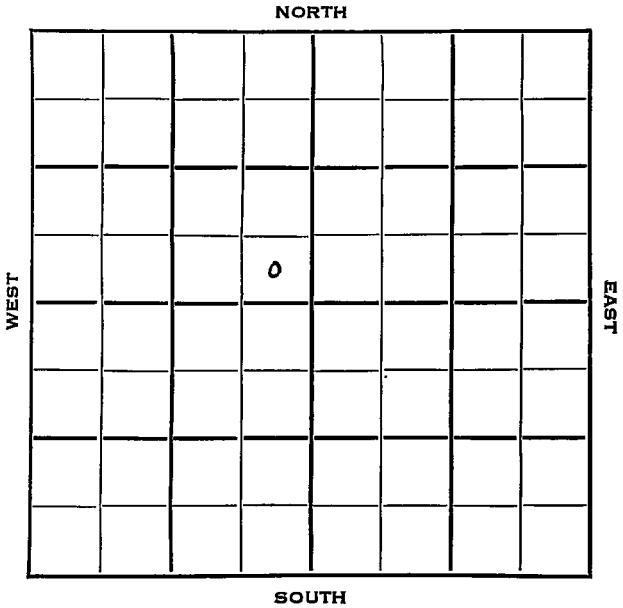

Stafford

KANSAS

SEC.	TWP.	R.
11	23	14W ✓

WELL NO.

#1 Miller

FARM

COMPANY

Natural Gas & Oil & Rep. Nat. Gas.

CONTRACTOR


Co. Tools.

_____ Ft. from N. Line

330 _____ Ft. from S. Line

330 _____ Ft. from E. Line

_____ Ft. from W. Line

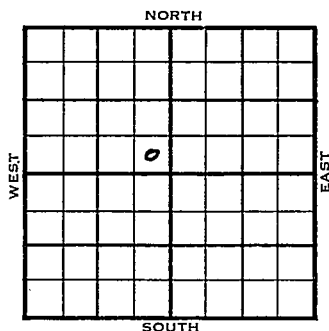


SE SE NW

	ELEVATION	REPORT
1954	1916'	
2/17	MIR	
2/24	8" @ 225' w/225 sks Drlg 2640'	
3/3	Spud 2-17-54 D & A TD 3984 8" @ 225 Heeb 3378 Br line 3507 Lans. 3525' DST 3642-58, open 1 hr rec 20' mud 1260# DST 3674-3706, open 1 hr rec 100' WCM 880# B KC 3761 Viola 3857 DST 3865-3918 open 1 hr rec 15' mud Off Simp. 3923 Arb. 3967 DST 3971-84 open 1 hr rec 2880' sul wtr. 1200# TD 3984' D & A ABANDONED	

J.G. - GEHEE

County Stafford State Kansas
 Sec. 11 (Blk.) 23 (Sur.) 14W Map No.
 Operator Natural Gas & Oil & Rep. Nat. Gas
 Well No. 1 Farm Miller
 Elev. 1946 Location SE SE NW

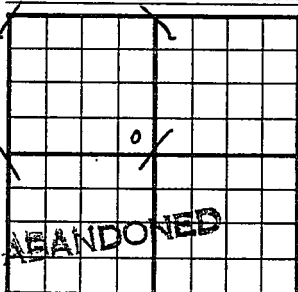

330 Ft. From S Line NW
330 Ft. From E Line Quarter

1st. Report

Completion MAR 3 1954

Remarks

Co. tools

Spudding Date 2-17-54

Drlg. Data D & A TD 3984

8" @ 225 Heeb. 3378 Br. lime 3507

Lans. 3525 DST 3642-58 open 1 hr.

Rec. 20' mud 1260# DST 3674-3706

open 1 hr. Rec. 100' wcm 880#

B KC 3761 Viola 3857 DST 3865-3918

open 1 hr. Rec. 15' mud 0#

Simp. 3923 Arb. 3967 DST 3971-84

open 1 hr. Rec. 2880' sul. wtr. 1200#

TD 3984

D & A

J. G. McGEHEE