

KANSAS


Pawnee

FORM '51 5M 4-41 PETROL

Section 11 Township 23 Range 17-W


Well No. #1 Paramore

Company Stanolind

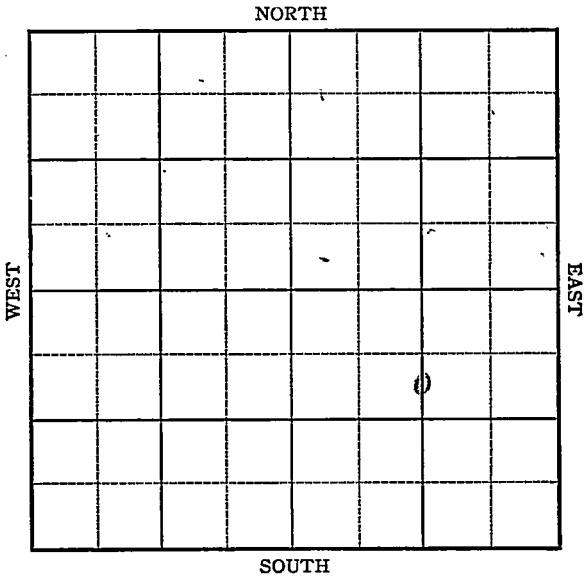

Map No. K-84 Sec. 11 Twp. 23 R. 17WWell No. 1 ParamoreStanolind Company**FIRST REPORT** ContractorC SL N $\frac{1}{2}$ SE

SECTION PLAT

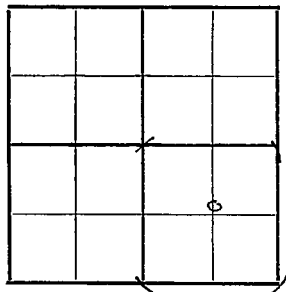990 Ft. from N. Line Ft. from S. Line1320 Ft. from E. Line Ft. from W. Line

WILDCAT

Location XXRig up

Drilling and Remarks:

RECORD

Cased in., ft.Sand Gas Oil Total Depth

PRODUCTION

1st 24 hrs. Nat. 1st 24 hrs. after shot Gas Cu. Ft.Dry Hole Abandoned

Date

OCT 29 1941 19S. J. LEWIS Scout

Pawnee

KANSAS

Map No. 84 Sec. 11 Twp. 23 R. 17W

Well No. 1 Paramore

Stanolind Company

ABANDONED Contractor

C SL N $\frac{1}{2}$ SE

990 Ft. from N. Line

_____ Ft. from S. Line

1320 Ft. from E. Line

_____ Ft. from W. Line

SECTION PLAT

WILDCAT

Location _____

Rig up _____

Drilling and Remarks:

Cor 4253

Water

RECORD

Cased _____ in., _____ ft.

Sand _____

Gas _____

Oil _____

Total Depth 4843

PRODUCTION

1st 24 hrs. Nat. _____

1st 24 hrs. after shot _____

Gas _____ Cu. Ft.

Dry Hole _____

Abandoned _____

Date

DEC 1 0 1941 19

S. J. LEWIS Scout