


DX 78-1

Section 11 Township 23 Range 3 4W  
Well No. #1 Niquette  
Company Northern Pump

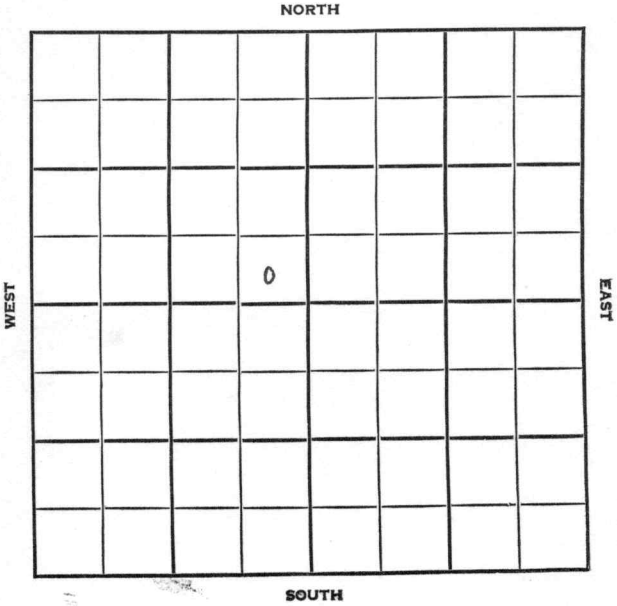

SEC.	TWP.	R.
11	23	34W


WELL NO. 1 Niquette FARM

COMPANY Northern Pump

CONTRACTOR

Hugoton Pool

\_\_\_\_\_ Ft. from N. Line  
 150 \_\_\_\_\_ Ft. from S. Line  
 150 \_\_\_\_\_ Ft. from E. Line  
 \_\_\_\_\_ Ft. from W. Line

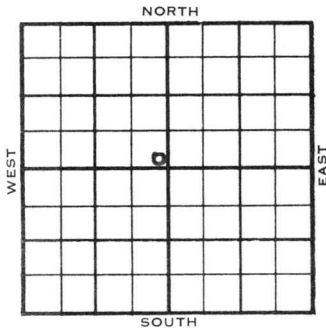

SE SE NW  
 Stanolind F/O

	ELEVATION	REPORT
1954	2943' RB	

5/19 Spud 5-12-54  
 10" @ 356'  
 D rlg. 1695'

5/26 RTD 2640'  
 Her 2514', Kr 2532', Win 2567', Tow 2625'  
 7" @ 2527', WOCT

6/9 CO

6/23 Spud 5-12-54 Gas well TD 2640  
 10" @ 356 Her. 2514 Kri. 2532  
 Win. 2567 Tow. 2625 TD 2640  
 7" @ 2527 CO to 2640 frac 120/2570-90.  
 60/2536-46 60/2516-26  
 SP 2595 Frac. 3,439,000 CFG 5 hr.  
 Comp. 9 1/2 MCFGPD 400#

**COMPLETED**



