


Section 11 Township 23 Range 35W

Well No. #2 Anderson (B)

Company Cities Service Oil

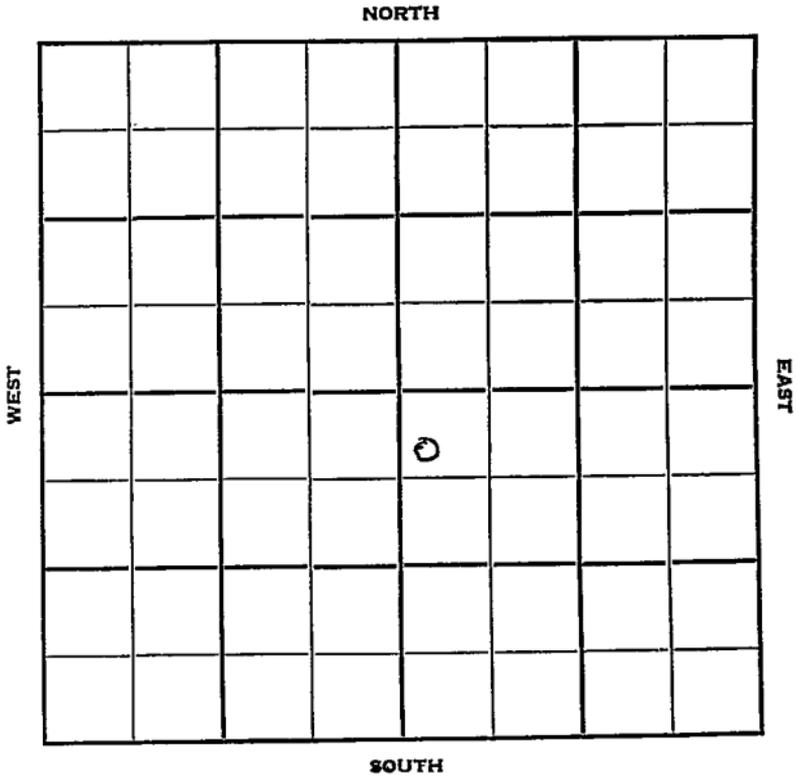

Kearny

KANSAS
R. 35 W

Sec. 11 Twp. 23

Well No. # 2 Anderson (B) Farm

Cities Service Oil Company

Contractor


Hugoton

400 Ft. from N. Line

_____ Ft. from S. Line

_____ Ft. from E. Line

100 Ft. from W. Line
NW SE (Old well abd.)

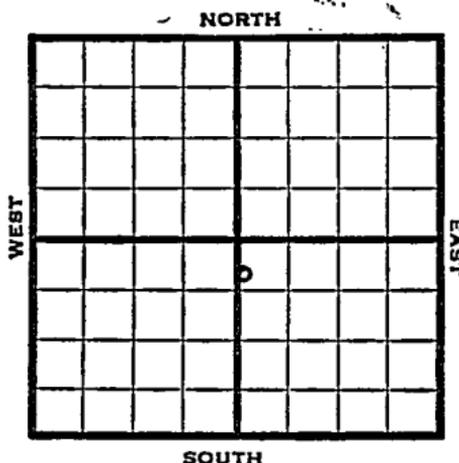

1951 Elev. 3012' REPORT

11/7 Location

12/19 Spud 11-6-51
Gas well TD 2660'
8" @ 799 5" @ 2659' TD 2660'
Her. 2485' Kri 2515' Win 2569'
Ft. Riley 2630'
CO to 2644' 60/2632-44 2000 A
water CO to 2619 50/2584-94
50/2568-78 70/2536-50
70/2516-30 22,000 A
Comp. 3,550,000 gas

COMPLETED

