


Section 11 Township 23 Range 37W

Well No. #1 Finklestein Gas Unit

Company Stanolind

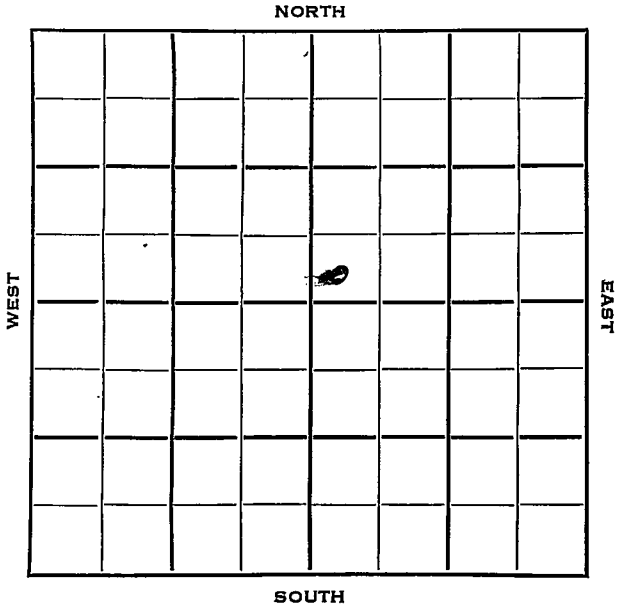

SEC.	TWP.	R.
11	23	37W ✓


WELL NO. #1 Finklestein Gas Unit FARM

COMPANY Stanolind

CONTRACTOR

Hugoton Pool

\_\_\_\_\_ Ft. from N. Line  
 150 \_\_\_\_\_ Ft. from S. Line  
 \_\_\_\_\_ Ft. from E. Line  
 150 \_\_\_\_\_ Ft. from W. Line

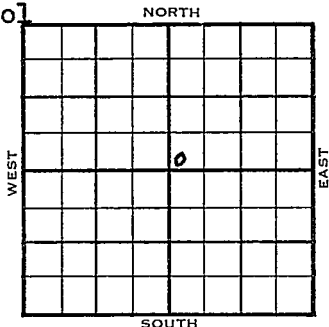

SW SW NE

	ELEVATION	REPORT
1954	3256'	

4/27 Location  
 5/5 Drlg 800'  
 5/12 8" @ 850' w/400 sks  
 RTD 2740'  
 Her. Kr. 2555', Win 2607', Tow 2667'  
 Ft. Riley 2713'  
 5" @ 2713'

5/19 WOCT.  
 5/26 WOCT  
 6/2 WOCT  
 6/15 Spud 5-2-54 Gas well TD 2740  
 8" @ 850 Her-Fri. 2555 Win. 2607  
 Tow. 2667 Ft. Riley 2713 5" @ 2713  
 DO to 2740 500 A 190,000 gas.  
 frac. 2,034,000 gas 10 GWPB  
 54/2553-62 102/2566-83 48/2604-12  
 18/2614-17 36/2620-26 66/2653-64  
 64/2672-86 30/2690-95  
 1,921,000 gas. frac. 1,426,000 gas.  
 80 GWPB  
 Comp. 3,320,000 CFGPD 370#

**COMPLETED**



