


Kearny,

KANSAS

SECTION 11 TOWNSHIP 23 RANGE 38 W

WELL NO. #1 Miles Gas Unit "C"

COMPANY Stanolind

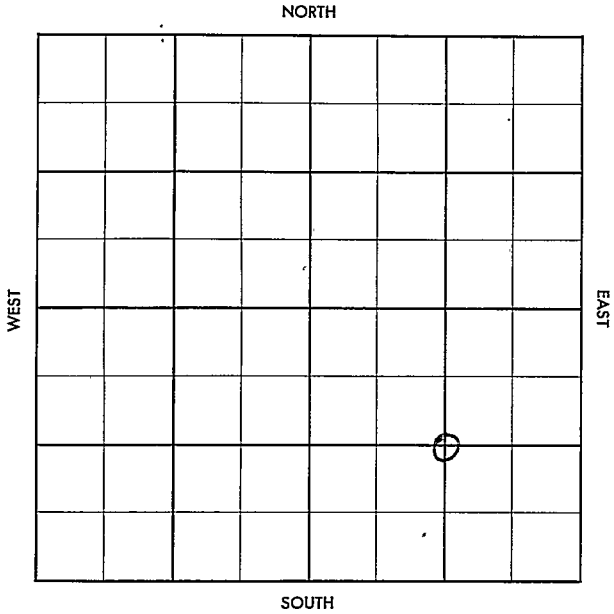

Kearny

KANSAS

SEC. 11	TWP. 23 -	R. 38W
------------	--------------	-----------

WELL NO.

#1 Miles Gas Unit "C"

FARM

COMPANY

Stanolind

CONTRACTOR

Noble

Hugoton


Ft. from N. Line

Ft. from S. Line

Ft. from E. Line

Ft. from W. Line

C SE/4

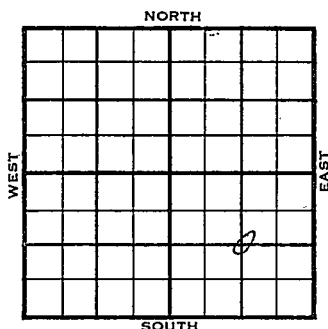

	ELEVATION	REPORT
1955	3347 RB, <del>3344</del> DF	
11-30	Location	
<u>1956</u>		
1-5	Comm. 12-5-55 8 5/8" @ 843 5 1/2" @ 2746/1000 CO to 2740 20/ 2729-34, 315 mcfg PB 2715, 48/ 2686-98, 24/ 2702-08, frac 435 mcfg PB 2675, 16/ 2636-40, 32/ 2644-52, # 36/ 2660-66 frac 300 mcfgpd, PB 2740x Comp. open flow 620 mcfgpd Herr. Kri. 2633 Winf 2682 TD 2728'	

COMPLETED

33 1/2 RB

County Kearny

Elev. 33 1/4 DF

Sec. 11 Twp. 23

Rge. 38W

Company Stanolind

Farm Name Niles Gas Unit "C" No. 1

Co.

TOPS	DEPTH	LOG	DATUM
Anh.			
Tp.			
H.			
Tr.			
Dg.			
Bl.			
L.			
K.C.			
B.K.C.			
Ce.			
C.			
M.			
M.			
K.			
Mz.			
Ma.			
V.			
S.			
S.			
A.			
R.			
Pe.			
G.			
T.D.			

Loc. in Sec. C SE 1/4

Geol. \_\_\_\_\_

Contr. \_\_\_\_\_

Noble

Pool \_\_\_\_\_

Hugoton

NOV 30 '55		
FIRST REPORT		

Lse.

No.

Sec.

T.

R.

Date Comm. \_\_\_\_\_

Location \_\_\_\_\_

~~34~~

3347 RB

County Kearny Elev. 3344 DFSec. 11 Twp. 23 Rge. 38WCompany StanolindFarm Name Miles Gas Unit "C" No. 1

TOPS	DEPTH	LOG	DATUM	Loc. in Sec.
Anh.				C SE/4
Tr.				
H. <u>Herrin-Kri</u>	<u>2633</u>			
Tr. <u>Wing</u>	<u>2682</u>			
Dg.				
Bl.				
L.				
K.C.				Geol.
B.K.C.				Contr.
Ce.				Noble
C.				
M.				Pool
M.				
K.				Hugoton
Mz.				
Mq.				
V.				
S.				
S.				
A.				
R.				
Pe.				
G.				
T.D.	<u>2728</u>			

COMPLETE

Date Comm. 12-5-55 JAN 5 19568 5/8" @ 843 5 1/2" @ 2746/1000 CO to2740 20/ 2729-34 315 mcfg PB 271548/ 2686-98 24/ 2702-08 frac435 mcfg PB 2675 16/ 2636-4032/ 2644-52 36/ 2660-66 frac300 mcfgpd PB 2740 Comp open flow620 mcfgpd