


KANSAS

Harvey

Section 12 Township 23 Range 2-W

Well Number 2 Denno

Company Western O & R

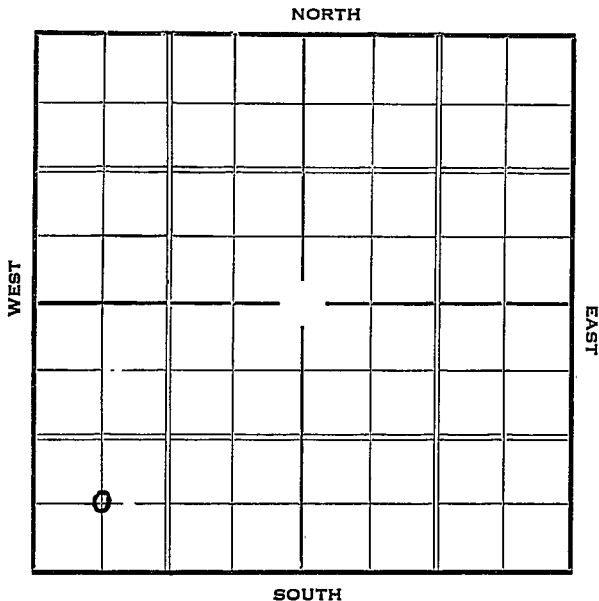

[illegible]

KANSAS

Map No. 39 Sec. 12 Twp. 23 R. 2W

Well No. 2 Deano

Western O & Ref. Company
Contractor

SECTION PLAT

 Ft. from N. Line

660 Ft. from S. Line

 Ft. from E. Line

660 Ft. from W. Line

0			

FIRST REPORT

Location

Rig up

Drilling and Remarks:

Rig

RECORD

Cased in., ft.

Sand

Gas

Oil

Total Depth

PRODUCTION

1st 24 hrs. Nat.

1st 24 hrs. after shot

Gas Cu. Ft.

Dry Hole

Abandoned

Date

JAN 6 1937₁₉

S. J. LEWIS Scout

KANSAS

Map No. 39 Sec. 12 Twp. 23 R. 2WWell No. 2, DennyWestern O & Ref. Company

Contractor

SECTION PLAT

0			

_____ Ft. from N. Line

660 Ft. from S. Line

_____ Ft. from E. Line

660 Ft. from W. Line

COMPLETED

Location _____

Rig up _____

Drilling and Remarks:

Ok 8-29-63Potential2558 natural

RECORD

Cased _____ in., _____ ft.

Sand _____

Gas _____

Oil _____

Total Depth 2988

PRODUCTION

1st 24 hrs. Nat. _____

1st 24 hrs. after shot _____

Gas _____ Cu. Ft.

Dry Hole _____

Abandoned _____

Date

FEB 10 1937

19

S. J. LEWIS Scout