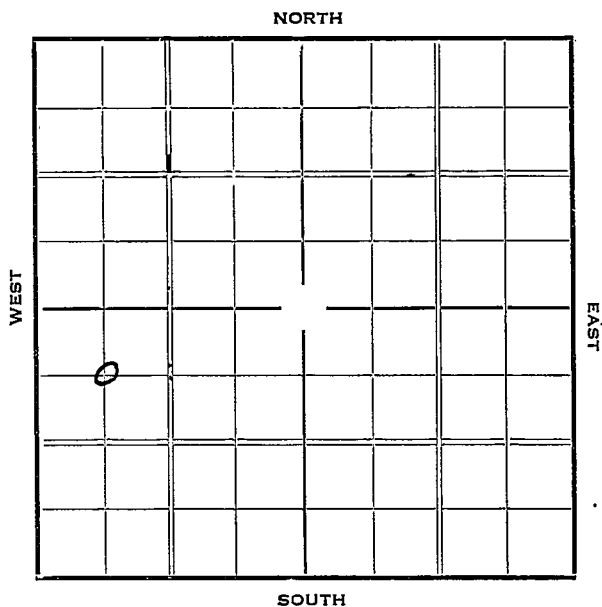


Section 12 Township 23 Range 2-WWell Number 1 DennoCompany Western Kansas O & Refg.

KANSAS

Harvey

Map No. Sec. 12 Twp. 23 R. 2W

Well No. 1 Denno Farm

Western Kansas O & Ref. Company


660 Ft. from N. Line

..... Ft. from S. Line

..... Ft. from E. Line

660 Ft. from W. Line

Elev. 1454

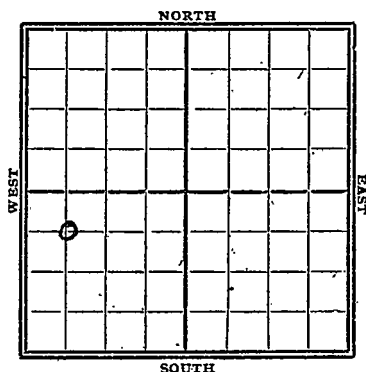Date
1936

REPORT

12/9 R.O.G.

12/17 Rigging up

12/24 12" @ 148'. Drlg. 1270'.

12/29 Drlg. 1340'.

1937

1/7 Chat 2968'. 6" @ 2988'. WOC

1/13 Chat 2968'. T. D. 2988'.

Pot. 4072.

COMPLETED

KANSASMap No. 39 Sec. 12 Twp. 23 R. 2W.Well No. 1 DennyWestern Kansas Oil & Ref. Company

Contractor

SECTION PLAT660 Ft. from N. Line

_____ Ft. from S. Line

_____ Ft. from E. Line

660 Ft. from W. Line

o			

FIRST REPORT

Location _____

Rig up _____

Drilling and Remarks:

ROG**RECORD**

Cased _____ in., _____ ft.

Sand _____

Gas _____

Oil _____

Total Depth _____

PRODUCTION

1st 24 hrs. Nat. _____

1st 24 hrs. after shot _____

Gas _____ Cu. Ft.

Dry Hole _____

Abandoned _____

Date

DEC 9 1936

19

S. J. LEWIS

Scout

KANSAS

Map No. 39 Sec. 12 Twp. 23 R. 2WWell No. 1 TennoWestern Kansas O & R. Company

Contractor

SECTION PLAT

660 Ft. from N. Line

_____ Ft. from S. Line

_____ Ft. from E. Line

660 Ft. from W. Line

COMPLETED

0			

Location _____

Rig up _____

Drilling and Remarks:

Ok 2968P 4072

RECORD

Cased _____ in., _____ ft.

Sand _____

Gas _____

Oil _____

Total Depth 2988

PRODUCTION

1st 24 hrs. Nat. _____

1st 24 hrs. after shot _____

Gas _____ Cu. Ft.

Dry Hole _____

Abandoned _____

Date

JAN 13 1937 19

S. J. LEWIS

Scout