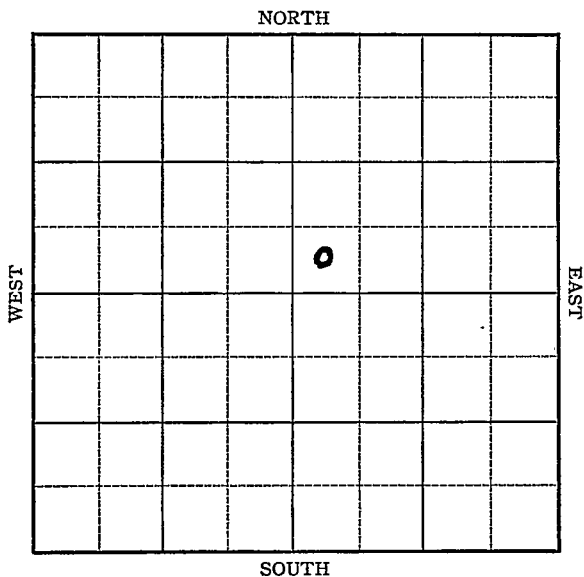


Reno

KANSAS

Section 12 Township 23 Range 4-WWell No. 2 TetenCompany Transwestern

Sec. 12 Twp. 23 R. 4 - W

Well No. #2 Teten Farm


Transwestern Company

Ft. from N. Line

330 Ft. from S. Line

Ft. from E. Line

330 Ft. from W. Line

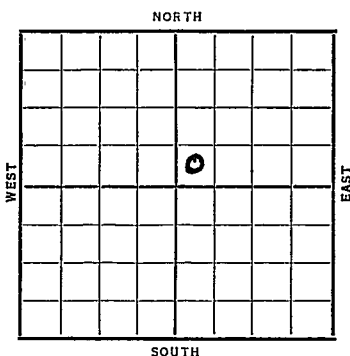

| Date  | REPORT                        |
|-------|-------------------------------|
| 1937  |                               |
| 12/1  | R. R.                         |
| 12/10 | "                             |
| 12/17 | "                             |
| 12/24 | Drl g. 395'.                  |
| 12/31 | 10" @ 490'. WOC.              |
| 1938  |                               |
| 1/7   | 12" @ 396'. Drl g. 2001'.     |
| 1/14  | Drl g. 3160'.                 |
| 1/20  | Chat 3254' 6" - 3430' T.D.    |
|       | No Shows Rept.                |
| 1/26  | 6" @ 3430'.                   |
|       | Chatt 3254'.                  |
|       | T.D. 3430'.                   |
|       | 78 shots 3352-60'.            |
|       | 3000 acid.                    |
|       | Potential 1651 bbls. Flowing. |
|       |                               |
|       | COMPLETED                     |

Reno

KANSAS

Map No. 40 Sec. 12 Twp. 23 R. 4WWell No. 2 TetenTranswestern

Company

Contractor

## FIRST REPORT

SW NE

Ft. from N. Line

330 Ft. from S. Line

Ft. from E. Line

330 Ft. from W. Line

## SECTION PLAT

|  |  |   |  |
|--|--|---|--|
|  |  |   |  |
|  |  | 0 |  |
|  |  |   |  |
|  |  |   |  |

Location \_\_\_\_\_

Rig up \_\_\_\_\_

Drilling and Remarks:

RR

## RECORD

Cased \_\_\_\_\_ in., \_\_\_\_\_ ft.

Sand \_\_\_\_\_

Gas \_\_\_\_\_

Oil \_\_\_\_\_

Total Depth \_\_\_\_\_

## PRODUCTION

1st 24 hrs. Nat. \_\_\_\_\_

1st 24 hrs. after shot \_\_\_\_\_

Gas \_\_\_\_\_ Cu. Ft.

Dry Hole \_\_\_\_\_

Abandoned \_\_\_\_\_

Date

DEC 1 - 1937 19

H. D. Hatfield

Scout

Reno **KANSAS**Map No. 40 Sec. 12 Twp. 23 R. 4WWell No. 2 TetenTranswestern Company

Contractor

**COMPLETED**

SW NE

       Ft. from N. Line330 Ft. from S. Line       Ft. from E. Line330 Ft. from W. Line**SECTION PLAT**

|  |  |   |  |
|--|--|---|--|
|  |  |   |  |
|  |  |   |  |
|  |  | 0 |  |
|  |  |   |  |
|  |  |   |  |

Location                     Rig up                     

Drilling and Remarks:

78 shots 3352-603000 acidPOT 16.51Flowing**RECORD**Cased 6 in., 3430 ft.Sand Chat 3254Gas                     Oil                     Total Depth 3430**PRODUCTION**1st 24 hrs. Nat.                     1st 24 hrs. after shot                     Gas                      Cu. Ft.Dry Hole                     Abandoned                     

Date

JAN 26 1938 19H. D. Hatfield Scout