

Section 12 Township 23 Range 4W
Well No. #1 Monford (Mon.tfort)
Company Lindsley Drlg.

NORTH

WEST

EAST

SOUTH

14

Reno KANSAS ✓

Sec. 12 Twp. 23 R. 4 W

Well No. # 1 Monford Farm

Lindsley Drlg. Company

Contractor


Ft. from N. Line

990 Ft. from S. Line

990 Ft. from E. Line

Ft. from W. Line

NW SE SW

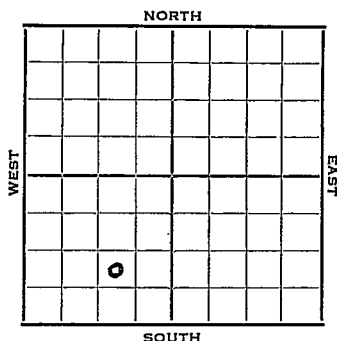

1952

Elev. 1487' REPORT

4/16

Drilling 2270'

4/23

8" @ 311 Miss 3271
DST 3353-62 1 hr. 50' M
DST 3354-73 1/2 RTD 1 hr. 22' HO&GCM
O# 5" @ 3362 WOCT

4/30

DP CO 3374' 1000 A S/1/2 BOPH
S/O & wtr. PB 3359' 30/3353-58
1000 A wtr plus VSSO
B/1-1/3 BO DD 3376'

5/7

3000 A S & test Tub & rods

5/14

POP

5/21

NR

5/28

"

6/11

"

6/18

"

6/25

"

7/2

"


7/9

"

7/16

Spud 4-5-52 Oil Well TD 3374
8" @ 311 Miss 3271
DST 3353-62 opn 1 hr. Rec. 50' rotary
mud
DST 3354-73 opn 1 hr. Rec. 22' ho &
gcm O# 5" @ 3362 CO to 3374 1000 A
S/1/2 boph S/12 go 12 gwph S/12 go
1 1/2 gwph PB 3359 30/3353-58
1000 A wtr & VSSO B/1 1/3 bo DP 3376
3000 A Comp. 20 bopd

COMPLETED

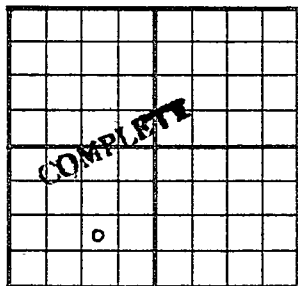County Reno State KansasSec. 12 (Blk. 23) (Sur. 4W) Map No.Operator Lindsley Drlg.Well No. 1 Farm MonfordElev. 1487 Location NW SE SW990 Ft. From S Line SW990 Ft. From E Line Quarter

1st. Report

Completion JUL 16 1952

Remarks

Spudding Date 4-5-52Drlg. Data Oil well TD 33748" @ 311 Miss. 3271 DST 3353-62open 1 hr. Rec. 50' rotary mudDST 3354-73 open 1 hr. Rec. 22' ho & gonO# 5" @ 3362 CO to 3374 1000 AS/ $\frac{1}{2}$ boph S/ 12 go 12 gwph S/ 12 go $1\frac{1}{2}$ gwph PB 3359-30/ 3353-58 1000 Awater & VSSO B/ 1 $\frac{1}{3}$ bo DP 33763000 A Comp. 20 bopd