


Map No. **KANSAS** Sec. 19 Twp. 23 R. 4w

Well No. 1 Mountford Farm
Tidel Oil Company

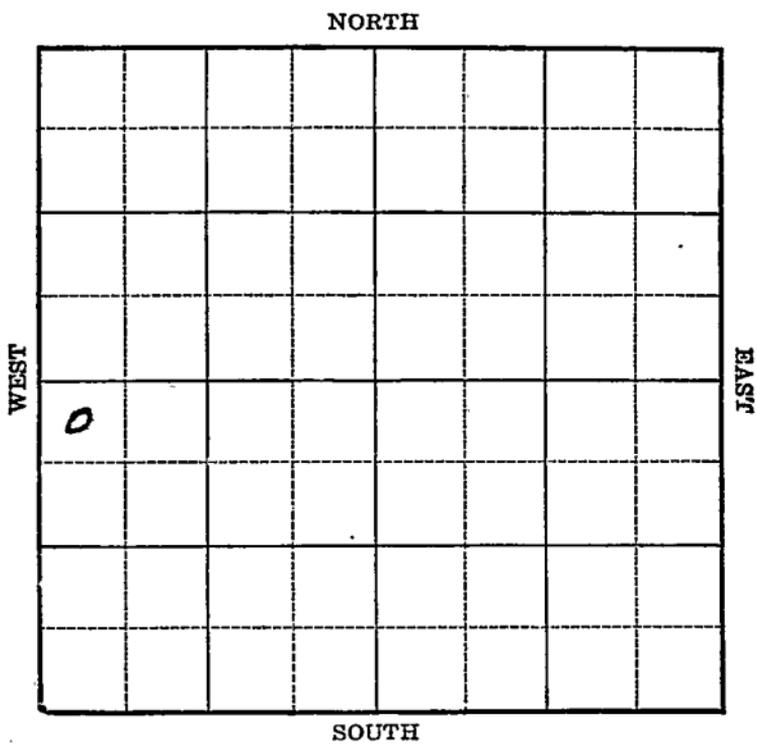

Location _____

Drilling Remarks _____

RECORD

Cased _____ in. _____ ft.

Sand _____

Gas _____

Oil _____

Total Depth _____

Rig Up _____

Drilling Remarks _____

PRODUCTION

1st 24 hrs. Nat. _____

1st 24 hrs. after shot _____

Gas _____ cu. ft.

Dry Hole _____

Abandoned _____

Reno

Map No. **KANSAS** Sec. 12 Twp. 23 R. 4W


Well No. 1 Montford Farm
Tidal Oil Company

330 Ft. from N. Line

Ft. from S. Line

Ft. from E. Line

330 Ft. from W. Line

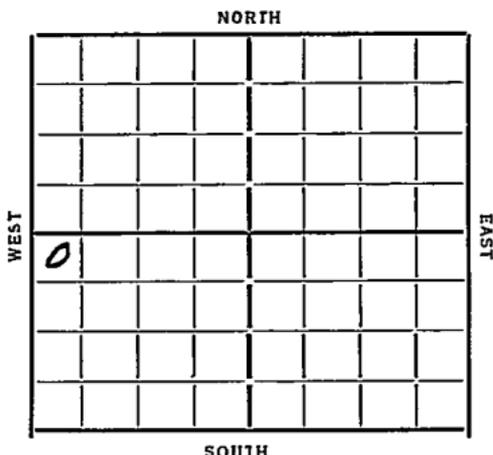

Date 1954

REPORT

10/10	Cellar
10/18	Rign
10/25	15 1/2 150 12 1/2 521 WOC
11/1	Sly 2547
11/8	" 3295 Chest 3263
11/15	Huntton 3618 A.O. Coring
11/22	8" 3618 Bailing
11/28	A.O. 3619 TD 3622 1/2
	1500' oil 1st hr Will acidize
12/6	1000 acid P 165 Bbls 4 hrs.
12/12	Huntton 3618 TD 3622 1/2
	1000 acid 1180 Bbls.

COMPLETED

Map No. 40 Sec. 12 Twp. 23 R. 4W

Well No. 1-Montford

Tidal oil

Company _____

Contractor _____

FIRST REPORTS

SECTION PLAT

330 Ft. from N. Line

_____ Ft. from S. Line

_____ Ft. from E. Line

330 Ft. from W. Line

0			

Location _____

Rig up _____

Drilling and Remarks:

cellar

RECORD

Cased _____ in., _____ ft.

Sand _____

Gas _____

Oil _____

Total Depth _____

PRODUCTION

1st 24 hrs. Nat. _____

1st 24 hrs. after shot _____

Gas _____ Cu. Ft.

Dry Hole _____

Abandoned _____

Date

10-10-34 19

ORVAL MANNSCHECK

Scout

Map No. 40 Sec. 12 Twp. 23 R. 4W

Well No. 1-Montford

Tidall Oil Company

Contractor

COMPLETED

SECTION PLAT

330 Ft. from N. Line

..... Ft. from S. Line

..... Ft. from E. Line

330 Ft. from W. Line

0			

Location.....

Rig up.....

Drilling and Remarks:

1000 acid

1180 bbls

RECORD

Cased..... in., ft.

Sand Hunton 3618

Gas.....

Oil.....

Total Depth 3622 1/2

PRODUCTION

1st 24 hrs. Nat.....

1st 24 hrs. after shot.....

Gas..... Cu. Ft.

Dry Hole.....

Abandoned.....

Date

12-17-37 192.....

ORVAL MANNSCHRECK

Scout