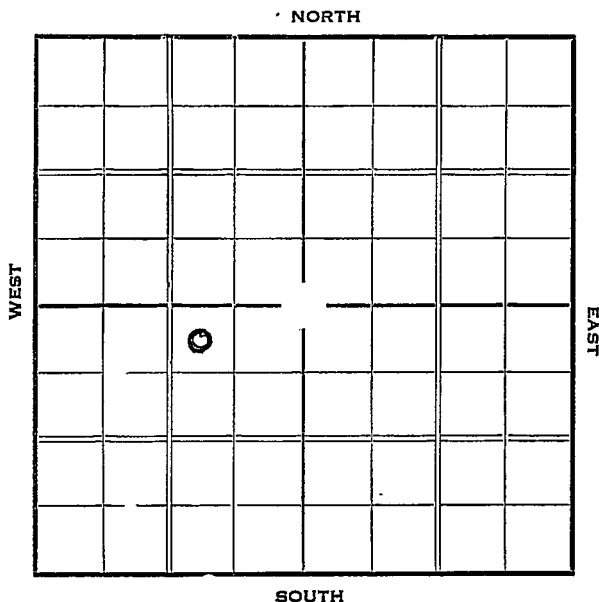



Reno

KANSAS

Section 12 Township 23 Range 4-WWell Number 1 MontfordCompany Wilcox O&G

KANSAS

Reno

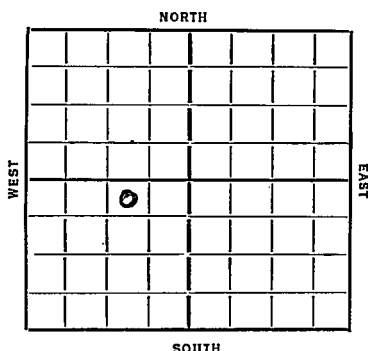Map No. _____ Sec. 12 Twp. 23 R. 4-WWell No. #1 Montford FarmWilcox O & G Company330 Ft. from N. Line Ft. from S. Line990 Ft. from E. Line Ft. from W. Line

Date	REPORT
1936	
12/22	Location
12/29	"
1937	
1/7	Location
1/14	"
1/21	Rig.
1/28	Rigging up.
2/4	12" @ 487'. WOC.
2/11	Drlg. 2210'.
2/18	Drlg. 2970'.
2/28	Chat 3268'. T.D. 3382 Show Oil
3/4	Fishing
3/11	" "
3/18	7" @ 3432' WOC 3332
3/25	" " " ?
3/31	Chat 3268'.
	T.D. 3382'.
	2000 acid.
	Potential 969①. 969 B/D
	COMPLETED ②

KANSAS

Keno.

Map No. _____ Sec. 12. Twp. 23 R. 4W

Well No. 1 Montford

Wilcox O & G. Company

Contractor _____

SECTION PLAT

	o		

330 Ft. from N. Line

_____ Ft. from S. Line

990 Ft. from E. Line

_____ Ft. from W. Line

COMPLETED

Location _____

Rig up _____

Drilling and Remarks:

Chat 3268
2000 acid
Potential
969

RECORD

Cased _____ in., _____ ft.

Sand _____

Gas _____

Oil _____

Total Depth 3382

PRODUCTION

1st 24 hrs. Nat. _____

1st 24 hrs. after shot _____

Gas _____ Cu. Ft.

Dry Hole _____

Abandoned _____

Date

MAR 31 1937 19

S. J. LEWIS Scout

KANSAS

Map No. 40 Sec. 12 Twp. 23 R. 4WWell No. 1 MontfordWilcox Oil Co. Company

Contractor

SECTION PLAT

320 Ft. from N. Line Ft. from S. Line990 Ft. from E. Line Ft. from W. Line

	0		

FIRST REPORT

Location ✓Rig up Drilling and Remarks:

RECORD

Cased in., ft.Sand Gas Oil Total Depth

PRODUCTION

1st 24 hrs. Nat. 1st 24 hrs. after shot Gas Cu. Ft.Dry Hole Abandoned

Date

DEC 22 1933

19

S. J. LEWIS Scout