


Section 12 Township 23 Range 4-W

Well No. #2 ~~#4~~ Montfort

Company Wilcox Oil & Gas

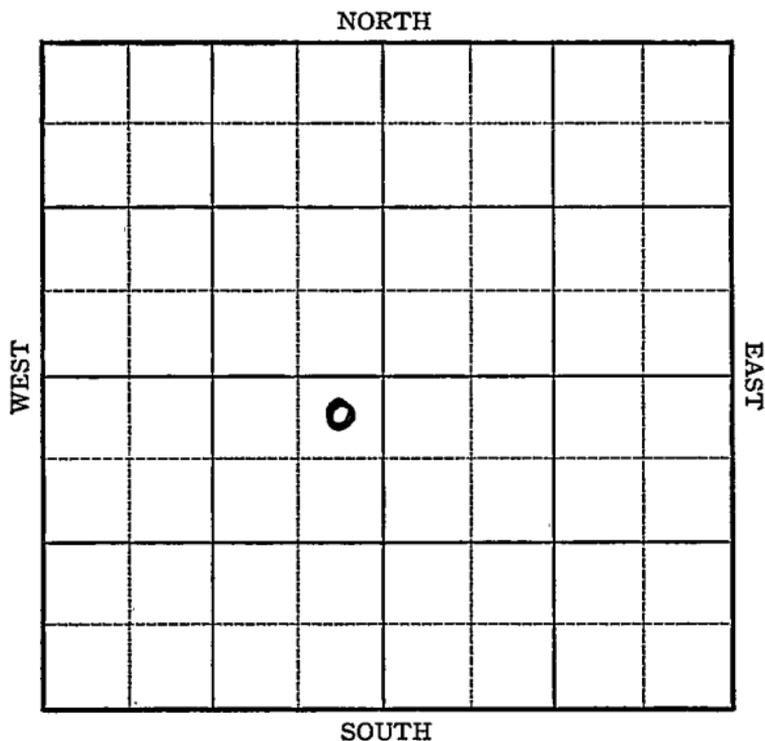


Sec. 12 Twp. 23 R. 4-WWell No. #4 Montfort #2 FarmWilcox Oil & Gas Company330 Ft. from N. Line

_____ Ft. from S. Line

330 Ft. from E. Line

_____ Ft. from W. Line

Elev. 1486

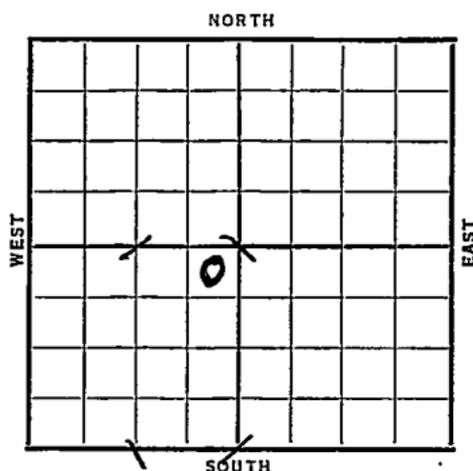

Date	REPORT
1937	
11/10	Rig.
11/19	R U R
11/26	S. H.
12/3	12" @ 304'. Drlg. 1010'.
12/10	Drlg. 2575'.
12/17	Chat 3261'. Drlg. 3270'.
	No shows.
12/24	7" @ 3434'.
	Perforated 3364-65'.
12/29	7" @ 3434'.
	Chat 3261'.
	T.D. 3434'.
	Shot 3364-65'.
	2000 acid.
	Potential 1260 bbls.
	Pump & flow.
	COMPLETED

Reno KANSAS

Map No. 40 Sec. 12 Twp. 23 R. 4WWell No. 4 MontfortWilcox Oil & Gas

Company

Contractor

FIRST REPORT

NE SW

330

Ft. from N. Line

Ft. from S. Line

330

Ft. from E. Line

Ft. from W. Line

SECTION PLAT

	0		

Location _____

Rig up _____

Drilling and Remarks:

Rig

RECORD

Cased _____ in., _____ ft.

Sand _____

Gas _____

Oil _____

Total Depth _____

PRODUCTION

1st 24 hrs. Nat. _____

1st 24 hrs. after shot _____

Gas _____ Cu. Ft.

Dry Hole _____

Abandoned _____

Date

NOV 10 1937

19

H. D. Hatfield

Scout

Reno KANSAS

Map No. 46 Sec. 12 Twp. 23 R. 4W

Well No. 2-Montfort

Wilcox O & G Company

Contractor

CORRECTION


SECTION PLAT

330 Ft. from N. Line

_____ Ft. from S. Line

330 Ft. from E. Line

_____ Ft. from W. Line

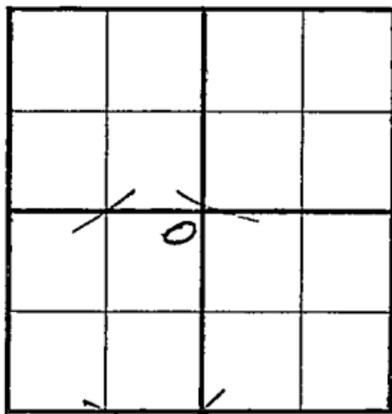

Location _____

Rig up _____

Drilling and Remarks:

*first reported
as #4 montfort
should have
been #2*

RECORD

Cased _____ in., _____ ft.

Sand _____

Gas _____

Oil _____

Total Depth _____

PRODUCTION

1st 24 hrs. Nat. _____

1st 24 hrs. after shot _____

Gas _____ Cu. Ft.

Dry Hole _____

Abandoned _____

Date

NOV 23 1937

19

E. D. Hatfield Scout

Reno

KANSAS

Map No. 40 Sec. 12 Twp. 23 R. 4W

Well No. 2 Montfort

Wilcox Oil & Gas Company

Contractor

SECTION PLAT

330 NE SW
Ft. from N. Line

_____ Ft. from S. Line

330 Ft. from E. Line

_____ Ft. from W. Line

COMPLETED

	0		

RECORD

Location _____

Cased 7 in., 3434 ft.

Rig up _____

Sand Chat 3261

Drilling and Remarks:

Gas _____

*Shot 3364-65
good acid*

Oil _____

Total Depth 3434

PRODUCTION

POT - 1260

1st 24 hrs. Nat. _____

1st 24 hrs. after shot _____

Gas _____ Cu. Ft.

Pump & Flow

Dry Hole _____

Abandoned _____

Date

DEC 29 1937 19

H. D. Hatfield Scout