


Section 12 Township 23 Range 4-W

Well Number X Montford #1-A

Company Wilcox O & G

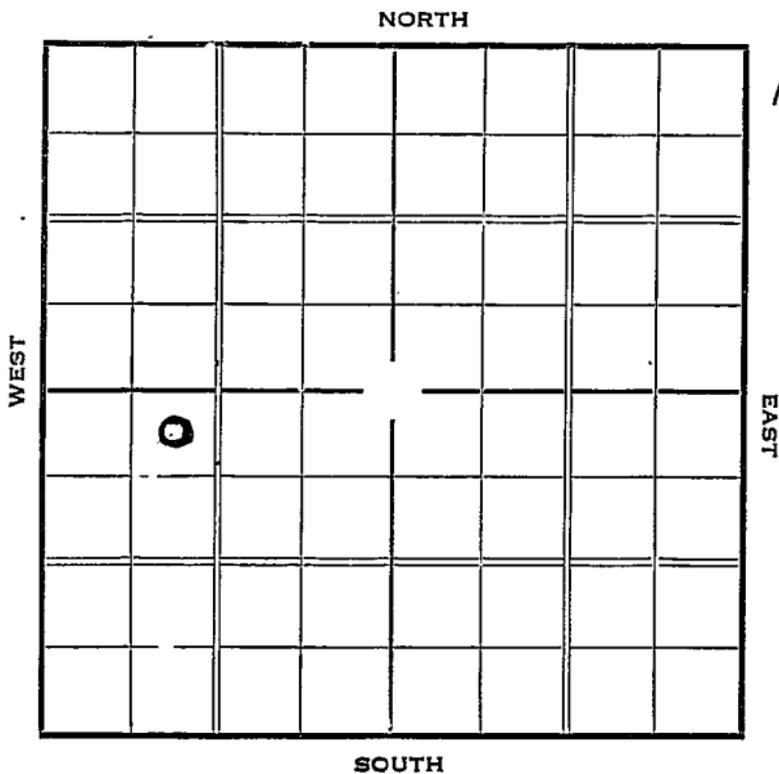

Sec. 12 Twp. 23 R. 4-W

Well No. ~~X~~ Montford #1-A Farm

Wilcox O & G Company


330 Ft. from N. Line

\_\_\_\_\_ Ft. from S. Line

\_\_\_\_\_ Ft. from E. Line

990 Ft. from W. Line

Elev. 1489

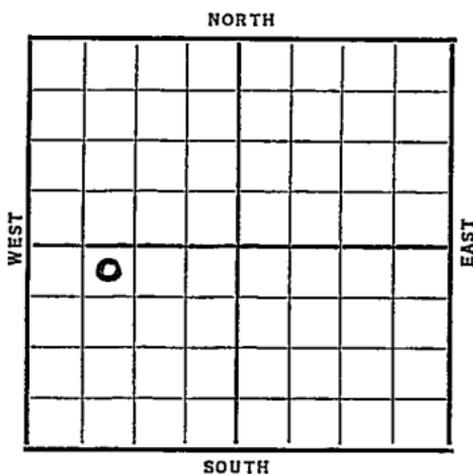

Date	REPORT
1937	
3/24	Location
4/2	Rig.
4/8	"
4/16	"
4/23	Drlg. 375'.
4/30	12" @ 487'. Drlg. 1119'.
5/7	Drlg. 2220'.
5/14	Drlg. 3324'.
5/21	Chat 3279'. Pay 3355-67'.
	T.D. 3415'. Shooting.
5/26	7" @ 3405'.
	Chat 3279'.
	T.D. 3415'.
	Shot W/Lane wells gun
	3405-60'.
	1500 acid.
	Pot. 789 bbls.
	<b>COMPLETED</b>

KANSAS *Revised*Map No. 40 Sec. 12 Twp. 23 R. 4W.Well No. 2 MontfordWilcox O & G Company

Contractor

## SECTION PLAT

	0		

330 Ft. from N. Line

\_\_\_\_\_ Ft. from S. Line

\_\_\_\_\_ Ft. from E. Line

990 Ft. from W. Line

## FIRST REPORT

Location ✓

Rig up \_\_\_\_\_

Drilling and Remarks:

## RECORD

Cased \_\_\_\_\_ in., \_\_\_\_\_ ft.

Sand \_\_\_\_\_

Gas \_\_\_\_\_

Oil \_\_\_\_\_

Total Depth \_\_\_\_\_

## PRODUCTION

\* 1st 24 hrs. Nat. \_\_\_\_\_

1st 24 hrs. after shot \_\_\_\_\_

Gas \_\_\_\_\_ Cu. Ft.

Dry Hole \_\_\_\_\_

Abandoned \_\_\_\_\_

Date

MAR 24 1937

19

S. J. LEWIS Scout

*Reno*

*OK*

Map No. 40 Sec. 12 Twp. 23 R. 4W

Well No. 1 - Montford "A"

Wilcox Company

Contractor

### CORRECTION

330 Ft. from N. Line

\_\_\_\_\_ Ft. from S. Line

\_\_\_\_\_ Ft. from E. Line

990 Ft. from W. Line

### SECTION PLAT

	0		

Location \_\_\_\_\_

Rig up \_\_\_\_\_

Drilling and Remarks:

*This was given out  
as #2 - Montford*

*YF*

### RECORD

Cased \_\_\_\_\_ in., \_\_\_\_\_ ft.

Sand \_\_\_\_\_

Gas \_\_\_\_\_

Oil \_\_\_\_\_

Total Depth \_\_\_\_\_

### PRODUCTION

1st 24 hrs. Nat. \_\_\_\_\_

1st 24 hrs. after shot \_\_\_\_\_

Gas \_\_\_\_\_ Cu. Ft

Dry Hole \_\_\_\_\_

Abandoned \_\_\_\_\_

Date

5-21- 1937

**H. D. Hatfield**

Sc

*Reno*

Map No. 40 Sec. 12 Twp. 23 R. 4<sup>w</sup>

Well No. 1 - Montford "A"

Wileox Company

Contractor

**COMPLETED**

**SECTION PLAT**

330 Ft. from N. Line

\_\_\_\_\_ Ft. from S. Line

\_\_\_\_\_ Ft. from E. Line

990 Ft. from W. Line

0			

*corrected section*

Location \_\_\_\_\_

Rig up \_\_\_\_\_

Drilling and Remarks:

*Shot w/ Lane wells  
Gun-3405-60*

*1500 Acid*

*Pot - 789*

**RECORD**

Cased 7 in., 3405 ft.

Sand Chat 3279

Gas \_\_\_\_\_

Oil \_\_\_\_\_

Total Depth 3415

**PRODUCTION**

1st 24 hrs. Nat. \_\_\_\_\_

1st 24 hrs. after shot \_\_\_\_\_

Gas \_\_\_\_\_ Cu. Ft.

Dry Hole \_\_\_\_\_

Abandoned \_\_\_\_\_

Date

MAY 26 1937 19

H. D. Hatfield

Scout