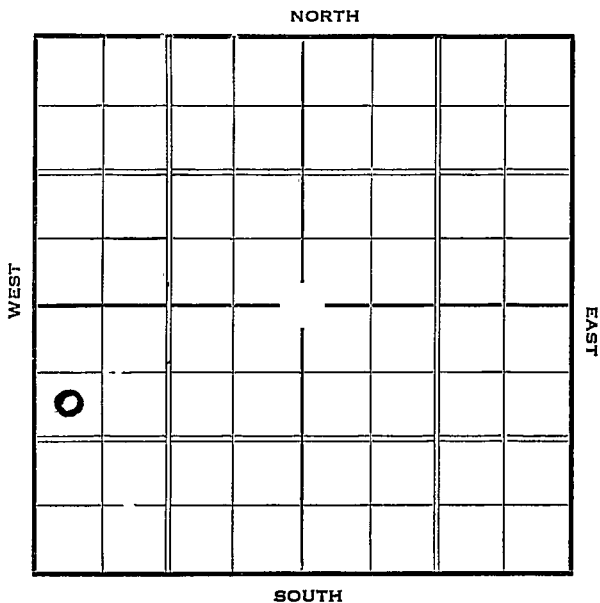


Section 12 Township 23 Range 4-WWell Number #2 Montford "A"Company Wilcox O & G

Map No. 40 Sec. 12 Twp. 23 R. 4 WWell No. 2-Montford "A"Wilcox O & L Company

Contractor

FIRST REPORT**SECTION PLAT**

990 Ft. from N. Line

Ft. from S. Line

Ft. from E. Line

330 Ft. from W. LineThey own all of W² SW except 10 Acres in NW/4

Location

Rig up

Drilling and Remarks:

B.R.R.**RECORD**

Cased in., ft.

Sand

Gas

Oil

Total Depth

PRODUCTION

1st 24 hrs. Nat.

1st 24 hrs. after shot

Gas Cu. Ft.

Dry Hole

Abandoned

Date

MAY 12 1937 19H. D. Hatfield Scout

Reno KANSAS

Map No. 40 Sec. 12 Twp. 23 R. 4WWell No. 2-Montford "A"Wilcox O & G Company

Contractor

COMPLETED

990 Ft. from N. Line

_____ Ft. from S. Line

_____ Ft. from E. Line

330 Ft. from W. Line

SECTION PLAT

6			

Location _____

Rig up _____

Drilling and Remarks:

1500 AcidPer- 453flowing

RECORD

Cased 7 in., 3405 ft.Sand Chat 3270

Gas _____

Oil _____

Total Depth 3418

PRODUCTION

1st 24 hrs. Nat. _____

1st 24 hrs. after shot _____

Gas _____ Cu. Ft.

Dry Hole _____

Abandoned _____

Date

JUN 23 1937

19

H. D. Hatfield

Scout