


Keno

Map No. KANSAS Sec. 12 Twp. 23 R. 4W
Well No. 2 Newfelt Farm
Wilcox Oil Co. Company

_____ Ft. from N. Line
990 Ft. from S. Line
_____ Ft. from E. Line
330 Ft. from W. Line

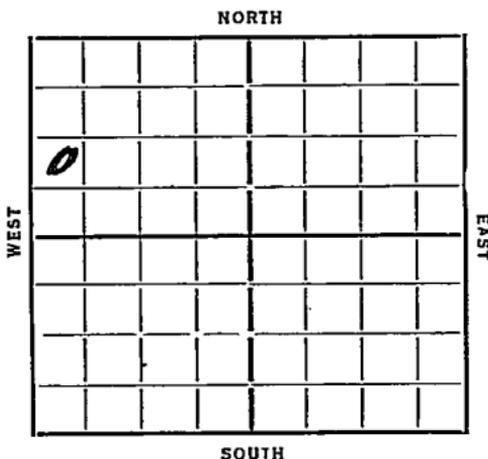

Date 1935

REPORT

<u>1/23</u>	<u>Callar</u>	
<u>1/31</u>	<u>Rig</u>	
<u>2/7</u>	<u>500</u>	<u>15" 185</u>
<u>2/14</u>	<u>1600</u>	<u>12" 2541</u>
<u>2/21</u>	<u>3040</u>	
<u>2/28</u>	<u>Chat 3280</u>	<u>Core 3615-17</u>
	<u>Remaining</u>	
<u>3/7</u>	<u>Hutton 3617</u>	<u>898 3616 Rust</u>
<u>3/14</u>	<u>3621 T1</u>	<u>2100 oil 1000 acid</u>
<u>3/20</u>	<u>Hutton 3617</u>	<u>T1 3621</u>
	<u>1000 acid</u>	<u>1433 1961</u>

COMPLETED

Map No. 40 Sec. 12 Twp. 23 R. 4W

Well No. 2-Neufeldt

Wilcoy O & A Company

Contractor

FIRST REPORTS

SECTION PLAT

..... Ft. from N. Line

990 Ft. from S. Line

..... Ft. from E. Line

330 Ft. from W. Line

0			

Location.....

Rig up.....

Drilling and Remarks:

cellar

RECORD

Cased..... in., ft.

Sand.....

Gas.....

Oil.....

Total Depth.....

PRODUCTION

1st 24 hrs. Nat.....

1st 24 hrs. after shot.....

Gas..... Cu. Ft.

Dry Hole.....

Abandoned.....

Date

1-23-35 192.....

ORVAL MANNSCHECK

Scout

Map No. 40 Sec. 12 Twp. 23 R. 4W

Well No. 2-Neufeldt

Wilcox Oil & Gas Company

Contractor

COMPLETED

SECTION PLAT

0			

.....Ft. from N. Line

990 Ft. from S. Line

.....Ft. from E. Line

330 Ft. from W. Line

Location.....

Rig up.....

Drilling and Remarks:

1000 acid

1433 lbs

RECORD

Cased..... in. ft.

Sand Hutton 3617

Gas.....

Oil.....

Total Depth 3621

PRODUCTION

1st 24 hrs. Nat.....

1st 24 hrs. after shot.....

Gas..... Cu. Ft.

Dry Hole.....

Abandoned.....

Date

3-20-35 192.....

DRVAL R... CHECK

Scout