


Section 12 Township 23 Range 4W

Well Number 4 Newfeldt

Company Wilcox O&G

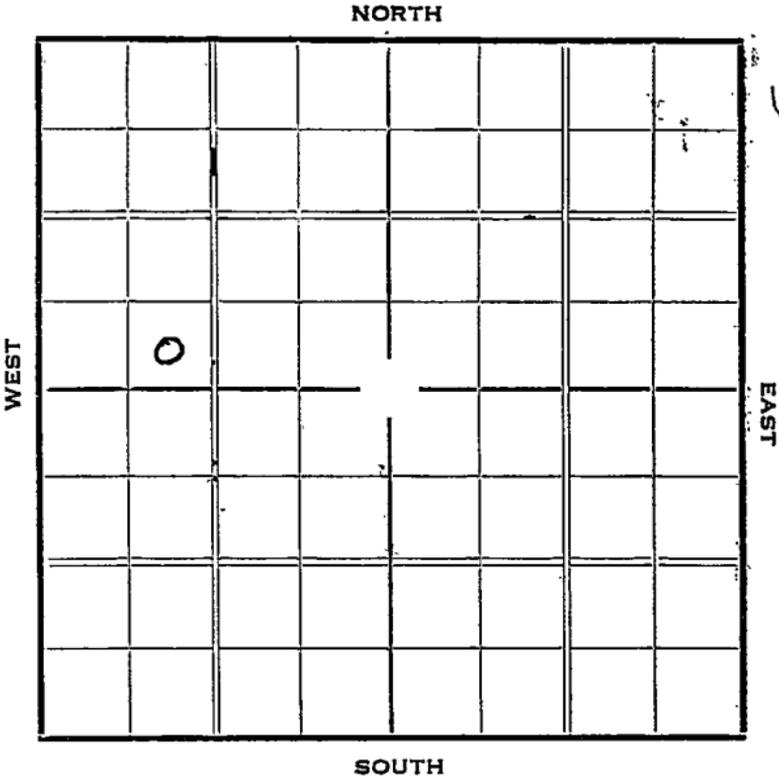

Sec. 12 Twp. 23 R. 4-W

Well No. #4 Neufeldt Farm
Wilcox O & G Company


_____ Ft. from N. Line

330 Ft. from S. Line

_____ Ft. from E. Line

990 Ft. from W. Line

Elev. 1489

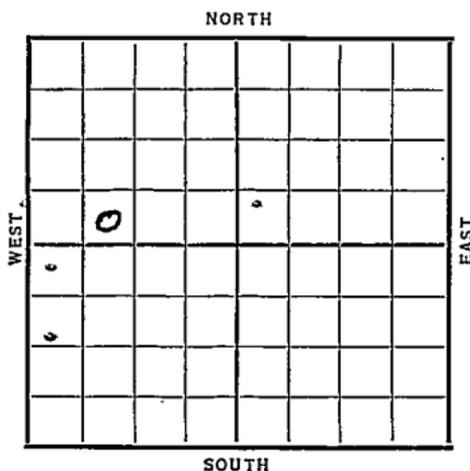

Date	REPORT
1936	
11/18	Cellar
11/27	Rigging up
12/3	Shut down.
12/10--	12/17--12/24--12/29--
1937	
1/7	Rigging up & shut down.
1/14	" " " "
1/21	" " " "
1/28	" " " "
2/4	R. U. & S. D.
2/11	" " "
2/18	" " "
2/26	" " "
3/4	" " "
3/11	" " "
3/18	" " "
3/25	" " "
4/2	" " "
4/8	10" @ 504' Drlg. 2340'
4/16	Drlg. 3255'.
4/23	7" @ 3420'. Woc.

OVER

1937

4/28 T.D. 3420'.
1500 acid.
Pot. 1513.

COMPLETED

Map No. 40 Sec. 12 Twp. 23 R. 4W

Well No. 4 Newfeldt

Wilcox O & G. Company

Contractor

SECTION PLAT

_____ Ft. from N. Line

330 Ft. from S. Line

_____ Ft. from E. Line

990 Ft. from W. Line

FIRST REPORT

Location _____

Rig up _____

Drilling and Remarks:

Cellar.

RECORD

Cased _____ in., _____ ft.

Sand _____

Gas _____

Oil _____

Total Depth _____

PRODUCTION

1st 24 hrs. Nat. _____

1st 24 hrs. after shot. _____

Gas _____ Cu. Ft.

Dry Hole _____

Abandoned _____

Date

NOV 18 1936

19

S. J. LEWIS

Scout

Reno KANSAS

Map No. 40 Sec. 12 Twp. 23 R. 4 WWell No. 4 - NeufeldtWilson O & G Company

Contractor

COMPLETED**SECTION PLAT**

_____ Ft. from N. Line

330 Ft. from S. Line

_____ Ft. from E. Line

990 Ft. from W. Line

Location _____

Rig up _____

Drilling and Remarks:

1500 AcidPit 1513**RECORD**

Cased _____ in., _____ ft.

Sand _____

Gas _____

Oil _____

Total Depth 3420**PRODUCTION**

1st 24 hrs. Nat. _____

1st 24 hrs. after shot _____

Gas _____ Cu. Ft.

Dry Hole _____

Abandoned _____

Date

APR 20 1918

19

H. D. Hatfield

Scout