


KANSAS

Section 12 Township 23 Range 4-W

Well Number 4 Neufeldt

Company Ledo et al

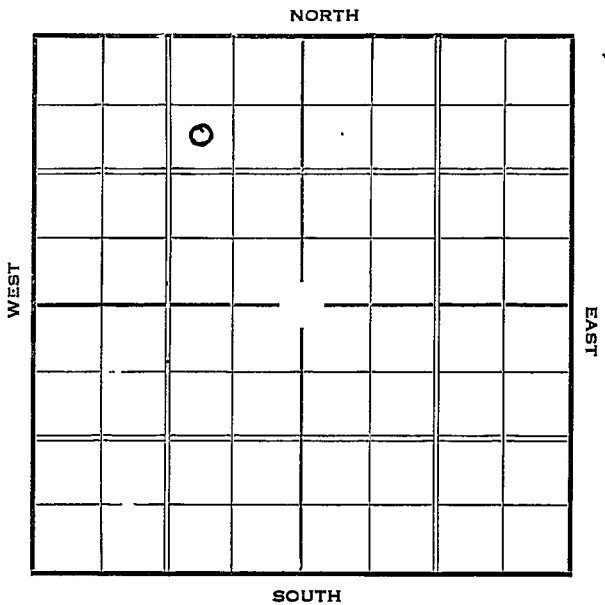

KANSAS *Perm.*Map No. 40 Sec. 12 Twp. 23 R. 4W.Well No. 4 NewfeldtLeco & Co Company

Contractor

SECTION PLAT

	0		

990 Ft. from N. Line

_____ Ft. from S. Line

990 Ft. from E. Line

_____ Ft. from W. Line

FIRST REPORT

Location _____

Rig up _____

Drilling and Remarks:

12" C280WOC**RECORD**

Cased _____ in., _____ ft.

Sand _____

Gas _____

Oil _____

Total Depth _____

PRODUCTION

1st 24 hrs. Nat. _____

1st 24 hrs. after shot _____

Gas _____ Cu. Ft.

Dry Hole _____

Abandoned _____

Date

MAR 24 1937 19S. J. LEWIS Scout

KANSAS

Map No. 40 Sec. 12 Twp. 23 R. 4^WWell No. 4 - NeufeldtLedo et al Company

Contractor

COMPLETED

SECTION PLAT

	0		

990 Ft. from N. Line

_____ Ft. from S. Line

990 Ft. from E. Line

_____ Ft. from W. Line

Location _____

Rig up _____

Drilling and Remarks:

1500 A.POT 1513 flowing

RECORD

Cased _____ in., _____ ft.

Sand Chat 3335Gas P3y 3414-20

Oil _____

Total Depth 3420

PRODUCTION

1st 24 hrs. Nat. _____

1st 24 hrs. after shot _____

Gas _____ Cu. Ft.

Dry Hole _____

Abandoned _____

Date

MAY 5 - 1937

19

Neufeldt Scout