


Reno

Section 12 Township 23 Range 4-W

Well No. 5 Teten

Company Transwestern

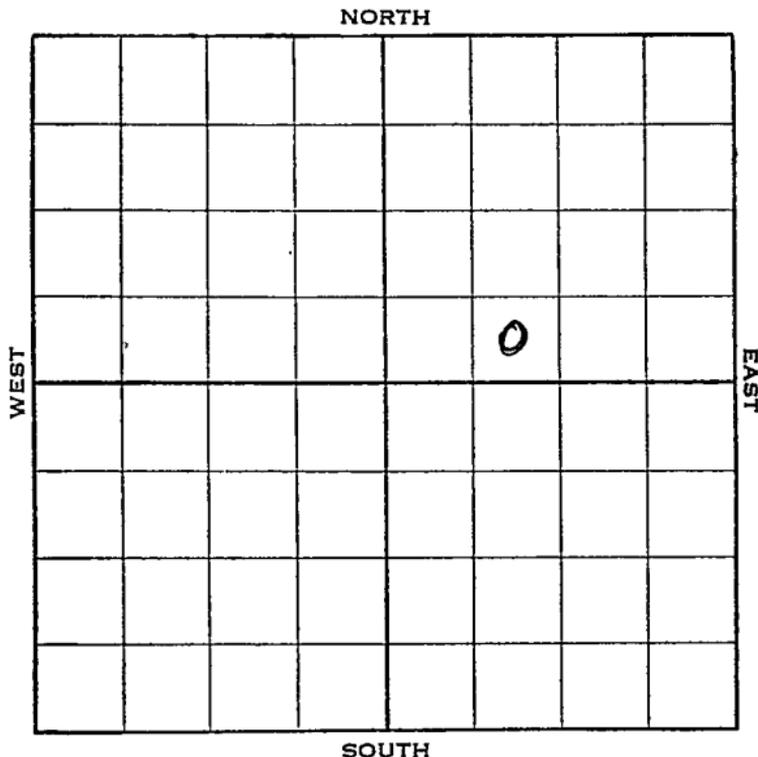

Sec. 12 Twp. 23 R. 4-W

Well No. #5 Teten Farm _____
Transwestern Company


_____ Ft. from N. Line

330 Ft. from S. Line

_____ Ft. from E. Line

990 Ft. from W. Line

Elev. 1489

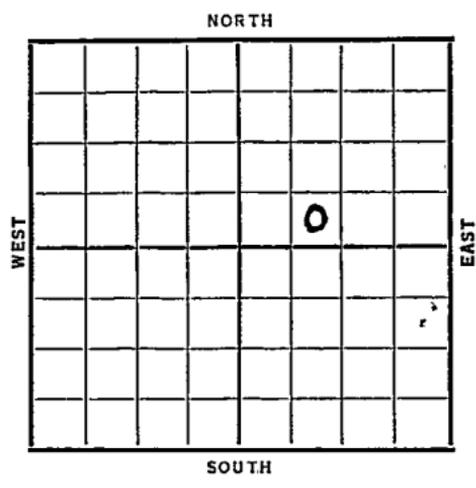

Date	REPORT
1938	
3/9	Location
3/18	10" @ 486'. Drlg. 1085'.
3/25	Drlg. 2730'.
4/1	Chat 3258'. 7" @ 3432'.
	T.D. 3433'. RUST.
4/8	Perf. 76 shots. Cleaning out.
4/13	7" @ 3432'.
	Chat. 3258'.
	T.D. 3432' (Corrected)
	Perf. 76 shots 3353-61'.
	Potential 284 bbls. oil (S. W.)
	COMPLETED

Reno

KANSAS

Map No. ~~40~~ ~~46~~ Sec. 12 Twp. 23 R. 4W

Well No. 5 Teter

Transwestern Company

Contractor

FIRST REPORT

SECTION PLAT

SE SW NE

Ft. from N. Line

330 Ft. from S. Line

Ft. from E. Line

990 Ft. from W. Line

		0	

Location **X**

Rig up

Drilling and Remarks:

RECORD

Cased _____ in., _____ ft.

Sand _____

Gas _____

Oil _____

Total Depth _____

PRODUCTION

1st 24 hrs. Nat. _____

1st 24 hrs. after shot _____

Gas _____ Cu. Ft.

Dry Hole _____

Abandoned _____

Date

MAR 9 - 1938 19

H. D. Hatfield Scout

