


Section 12 Township 23 Range 4-W

Well No. 7 Tetten (*Teten*)

Company Transwestern

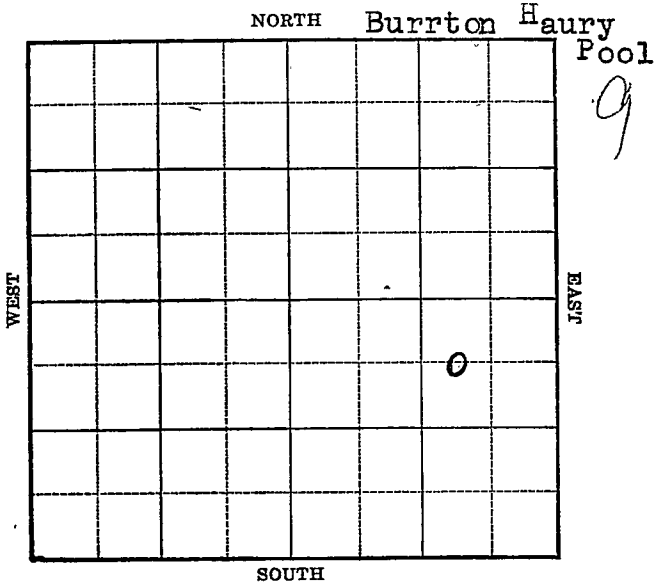

Sec. 12 Twp. 23 R. 4-W

Well No. #7 Tetten Farm

Transwestern Company

(Burrton Haury)


660 Ft. from N. Line

 Ft. from S. Line

990 Ft. from E. Line

 Ft. from W. Line

Elev. 1493

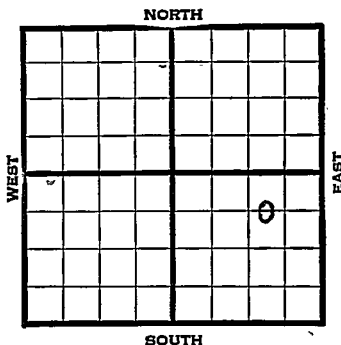

1939	REPORT
5/24	Rotary.
6/1	12" - 517' WOC.
6/8	Drlg. 2200'
6/16	3240'
6/23	Chat. 3259' Pay 3353-59'
	7" - 3439' T.D.
	60 shots 3353-59' trace water &
	show oil. Shut down.
6/29	2000 acid.
	47 shots 3346-53' No test.
7/6	" " " " "
7/13	Pump 184 bbls, cut 10% 24 hrs.
7/20	" " " " "
7/27	" " " " "
	OVER

1939
8/2

Chat. 3259'

7" - 3439'

T.D. 3439'

60 shots 3353-59'

47 shots 3346-53'

2000 acid.

Pump 184 bbls. Cut 50%.

COMPLETED

Map No. 40 Sec. 12 Twp. 23 R. 4W

Well No. 7 Tetten

Transwestern

Company

Contractor

FIRST REPORT

C W L N E S E

SECTION PLAT

660 Ft. from N. Line

_____ Ft. from S. Line

990 Ft. from E. Line

_____ Ft. from W. Line

			0

BURRTON HAURY POOL

Location _____

Rig up _____

Drilling and Remarks:

ROTARY

RECORD

Cased _____ in.; _____ ft.

Sand _____

Gas _____

Oil _____

Total Depth _____

PRODUCTION

1st 24 hrs. Nat. _____

1st 24 hrs. after shot _____

Gas _____ Cu. Ft.

Dry Hole _____

Abandoned _____

Date

MAY 24 1939

S. J. LEWIS Scout

Map No. 40 Sec. 12 Twp. 23 R. 4WWell No. 7 TettenTranswestern

Company

Contractor

COMPLETED

C W L NE SE

660 Ft. from N. Line

_____ Ft. from S. Line

990 Ft. from E. Line

_____ Ft. from W. Line

SECTION PLAT

			0

BURRTON-HAURY POOL

Location _____

Rig up _____

Drilling and Remarks: .

*Chay 3259**7" C 3439**60 Blots 3353-59**47 " 3346-53**2000 acid**Pump 184 cut**50%*

RECORD

Cased _____ in., _____ ft.

Sand _____

Gas _____

Oil _____

Total Depth 3489

PRODUCTION

1st 24 hrs. Nat. _____

1st 24 hrs. after shot _____

Gas _____ Cu. Ft.

Dry Hole _____

Abandoned _____

Date

AUG 2 1939

19

S. J. LEWIS Scout