


Section 12 Township 23 Range 4W

Well No. #9 Teten

Company Sunray

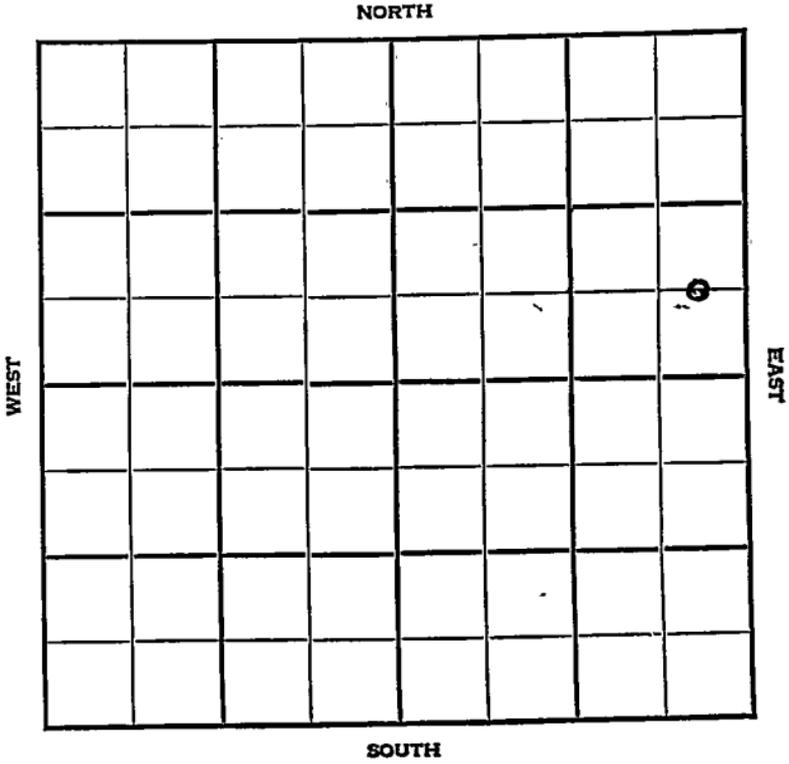

KANSAS

Reno

Sec. 12 Twp. 23 R. 4W

Well No. #9 Teten Farm

Sunray Company

Burton Pool

Ft. from N. Line

660'


Ft. from S. Line

330'

Ft. from E. Line

Ft. from W. Line

C E L SE NE

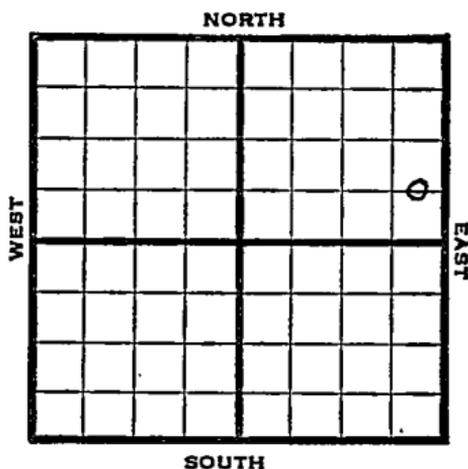

1948 Elev. 1490' REPORT

2/4	Location
2/11	"
2/18	8" @ 500' Drlg 2610'
2/25	Mississippi 3285 TD 3347' 5" @ 3343' RUST
3/3	TD 3367' 2000 Acid Swb 1 bbl oil PH
3/10	"
3/17	"
3/24	"
3/31	"
4/7	"
4/14	"
4/21	"
4/28	Miss 3285' 5" @ 3343' 2000 Acid Pump 25 oil Pot. Gr. 42° TD 3367'

**COMPLETED**

Map No. \_\_\_\_\_ Sec. 12 Twp. \_\_\_\_\_ R. \_\_\_\_\_

Well No. 9 Teten \_\_\_\_\_

Sunray \_\_\_\_\_ Company

FIRST REPORT \_\_\_\_\_ Contractor

C E L S E N E

SECTION PLAT

\_\_\_\_\_ Ft. from N. Line

660 Ft. from S. Line

330 Ft. from E. Line

\_\_\_\_\_ Ft. from W. Line


Reno County

Location X \_\_\_\_\_

Rig up \_\_\_\_\_

Drilling and Remarks:

RECORD

Cased \_\_\_\_\_ in., \_\_\_\_\_ ft.

Sand \_\_\_\_\_

Gas \_\_\_\_\_

Oil \_\_\_\_\_

Total Depth \_\_\_\_\_

PRODUCTION

1st 24 hrs. Nat. \_\_\_\_\_

1st 24 hrs. after shot \_\_\_\_\_

Gas \_\_\_\_\_ Cu. Ft.

Dry Hole \_\_\_\_\_

Abandoned \_\_\_\_\_

Date

FEB 4 1948 19

S. J. LEWIS Scout

Map No. 40 Sec. 12 Twp. 23 R. 4W

Well No. 9 Teten

Sunray Company

**COMPLETE**

Contractor

C E L S E N E

E. I. 1990  
SECTION PLAT

         Ft. from N. Line

660 Ft. from S. Line

330 Ft. from E. Line

         Ft. from W. Line


Reno County

Location         

Rig up         

Drilling and Remarks:

*Miss 3285  
511 @ 3343  
2000 acic  
Pump 25 oil Prod.  
H2O*

RECORD

Cased          in.,          ft.

Sand         

Gas         

Oil         

Total Depth 2367

PRODUCTION

1st 24 hrs. Nat.         

1st 24 hrs. after shot         

Gas          Cu. Ft.

Dry Hole         

Abandoned         

Date

APR 28 1948 19

S. J. LEWIS Scout