


Reno

KANSAS
FORM 51 5M PETROL

Section 12 Township 23 Range 5W

Well No. #1, Bernice

Company Phillips

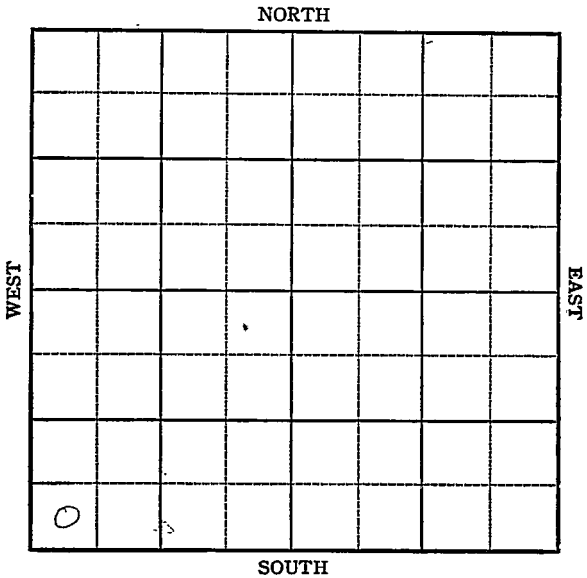

Reno

Sec. 12 Twp. 23 R. 5W

Well No. #1 Bernice Farm

Phillips Company

Wildcat


 Ft. from N. Line

410 Ft. from S. Line

 Ft. from E. Line

330 Ft. from W. Line

Elev. 1530

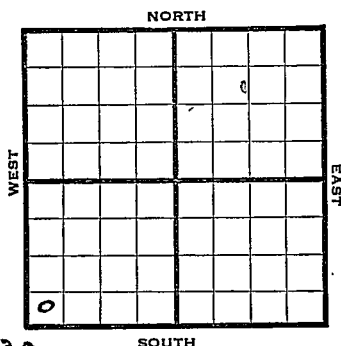

1944

REPORT

5/24 Location
5/31 " "
6/7 Rotary
6/15 Drlg. 1275
6/21 Lans 2744
Drlg. 3150
7/5 Misener 3758
Viola 3878
Arb. 3986
TD 4016

ABANDONED

KANSASPool Name WildcatMap No. 40 Sec. 12 Twp. 23 R. 5WWell No. 1 BernicePhillips

Company

FIRST REPORT

Contractor

SW/C

SECTION PLAT

 Ft. from N. Line410 Ft. from S. Line Ft. from E. Line330 Ft. from W. LineReno CountyLocation XRig up

Drilling and Remarks:

RECORDCased in., ft.Sand Gas Oil Total Depth **PRODUCTION**1st 24 hrs. Nat. 1st 24 hrs. after shot Gas Cu. Ft.Dry Hole Abandoned

Date

MAY 24 194419S. J. LEWIS

Scout

KANSAS

Pool Name WildcatMap No. 40 Sec. 12 Twp. 23 R. 5WWell No. 1 BernicePhillips

Company

ABANDONED

Contractor

SW/C

SECTION PLAT

 Ft. from N. Line410 Ft. from S. Line Ft. from E. Line330 Ft. from W. LineReno CountyLocation Rig up

Drilling and Remarks:

*Miner 3878**W 3878**Ar 3986*

RECORD

Cased in., ft.Sand Gas Oil Total Depth 4016

PRODUCTION

1st 24 hrs. Nat. 1st 24 hrs. after shot Gas Cu. Ft.Dry Hole Abandoned

Date

JUL 5 1944 19 S. J. LEWIS Scout