


Section 12 Township 23 Range 10-W

Well No. #4 Heylum "B"

Company Cities Service Oil  
Peace Creek Pool

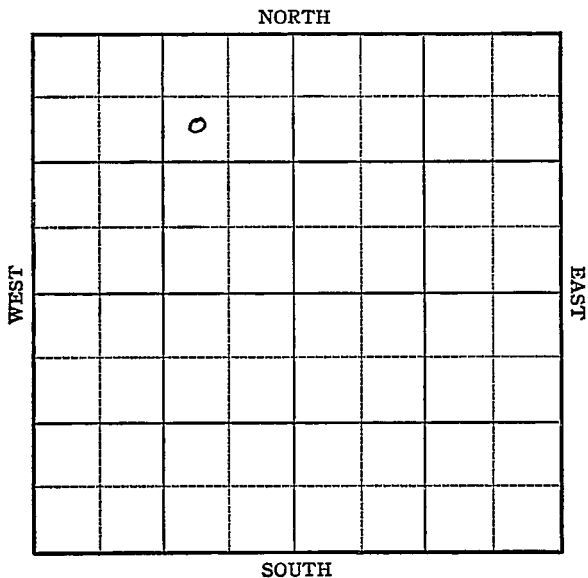

Sec. 12 Twp. 23 R. 10-W

Well No. #4 Heylum "B" Farm

Cities Service Oil Company

(Peace Creek Pool)


990 Ft. from N. Line

\_\_\_\_\_ Ft. from S. Line

990 Ft. from E. Line

\_\_\_\_\_ Ft. from W. Line

Elev. 1758

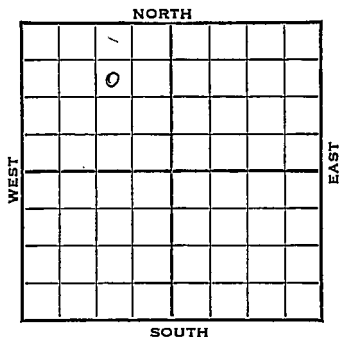

1942

REPORT

7/29

Location

8/5

8" - 243

Drlg. 2470'

8/12

Drlg 3625

8/19

Lans. 3242

Miss. 3586

Kind. 3628

Viola 3750-54 T.D.

5" - 3752 RUST.

8/27

Viola 3743 corrected 5" @ 3745  
TD 3742 60' water in 3 hrs SD

9/2

Viola 3743

5" - 3745

500 acid

T.D. 3751

Bomb Pot. 3000

Gravity 42.

**COMPLETED**

Reno

KANSAS

Map No. 47 Sec. 12 Twp. 23 R. 10W

Well No. 4 Heylum "B"

Cities Service Oil Company

FIRST REPORT Contractor

SW NE NW

SECTION PLAT

990 Ft. from N. Line


\_\_\_\_\_ Ft. from S. Line

990 Ft. from E. Line

\_\_\_\_\_ Ft. from W. Line

PEACE CREEK POOL

Location XXX

RECORD

Rig up \_\_\_\_\_

Drilling and Remarks:

Cased \_\_\_\_\_ in., \_\_\_\_\_ ft.

Sand \_\_\_\_\_

Gas \_\_\_\_\_

Oil \_\_\_\_\_

Total Depth \_\_\_\_\_

PRODUCTION

1st 24 hrs. Nat. \_\_\_\_\_

1st 24 hrs. after shot \_\_\_\_\_

Gas \_\_\_\_\_ Cu. Ft.

Dry Hole \_\_\_\_\_

Abandoned \_\_\_\_\_

Date

JUL 29 1942

19

S. J. LEWIS Scout

