


Section 12 Township 23 Range 10W

Well No. 3 Weideroder

Company Lion Oil

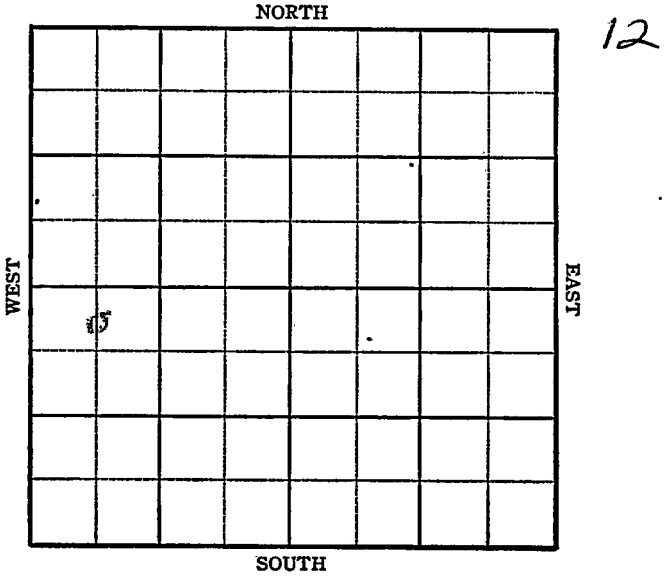

**KANSAS**

**Reno County**

Sec. 12 Twp. 23 R. 10W

Well No. #3 Weideroder Farm

Lion Oil Company

**Peace Creek**


330 Ft. from N. Line

\_\_\_\_\_ Ft. from S. Line

\_\_\_\_\_ Ft. from E. Line

660' Ft. from W. Line

**CNL NW SW**

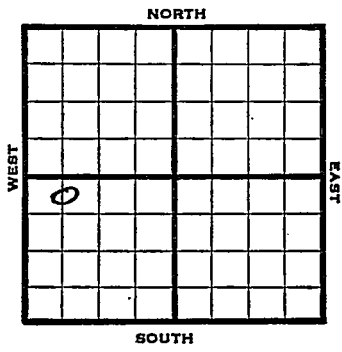

1945

Elev. 1761 **REPORT**

10/31

Location

11/7

8" @ 313  
Drlg. 1750'

11/14

Drlg. 3642'

11/21

Viola 3758  
TD 3760  
5" @ 3758 RUST

11/28

500 acid.  
Swab 6 oil per hr.

12/5

" " " "

12/12

" " " "

12/20

" "

12/29

" "

1946

1/9

Viola 3758  
5" @ 3758  
500 acid.  
TD 3765  
Pump 94 Pot.  
Grav. 42.0

**COMPLETED**

**KANSAS** Kansas Pool Name Peace Creek

Map No. 47 Sec. 12 Twp. 23 R. 10W

Well No. 3 Weideroder

Lion Oil Company

**FIRST REPORT** Contractor

C N L NW SW

**SECTION PLAT**

330 Ft. from N. Line

\_\_\_\_\_ Ft. from S. Line

\_\_\_\_\_ Ft. from E. Line

660 Ft. from W. Line

o			

Reno County

Location X

Rig up \_\_\_\_\_

Drilling and Remarks:

**RECORD**

Cased \_\_\_\_\_ in., \_\_\_\_\_ ft.

Sand \_\_\_\_\_

Gas \_\_\_\_\_

Oil \_\_\_\_\_

Total Depth \_\_\_\_\_

**PRODUCTION**

1st 24 hrs. Nat. \_\_\_\_\_

1st 24 hrs. after shot \_\_\_\_\_

Gas \_\_\_\_\_ Cu. Ft.

Dry Hole \_\_\_\_\_

Abandoned \_\_\_\_\_

Date

OCT 3 1 1945 19

S. J. LEWIS Scout

KANSAS Kansas Pool Name Peace Creek

Map No. 47 Sec. 12 Twp. 23 R. 10W

Well No. 3 Weideroder

Lion Oil Company

**COMPLETED** Contractor

C N L NW SW

*E 11/26/*  
SECTION PLAT

330 Ft. from N. Line

\_\_\_\_\_ Ft. from S. Line

\_\_\_\_\_ Ft. from E. Line

660 Ft. from W. Line

6			

Reno County

Location \_\_\_\_\_

Rig up \_\_\_\_\_

Drilling and Remarks:

*Vista 3758.*  
*5C 3758.*  
*500 acid*  
*Pump 94 Rd*  
  
*42 0/12*

**RECORD**

Cased \_\_\_\_\_ in., \_\_\_\_\_ ft.

Sand \_\_\_\_\_

Gas \_\_\_\_\_

Oil \_\_\_\_\_

Total Depth 3765

**PRODUCTION**

1st 24 hrs. Nat. \_\_\_\_\_

1st 24 hrs. after shot \_\_\_\_\_

Gas \_\_\_\_\_ Cu. Ft.

Dry Hole \_\_\_\_\_

Abandoned \_\_\_\_\_

Date

JAN 9 1946 19

S. J. LEWIS Scout