

# KANSAS


Reno

FORM 51 5M 10-41 PETROL

Section 12 Township 23 Range 10-W

Well No. #2 Heylum "C"

Company Cities Service Oil

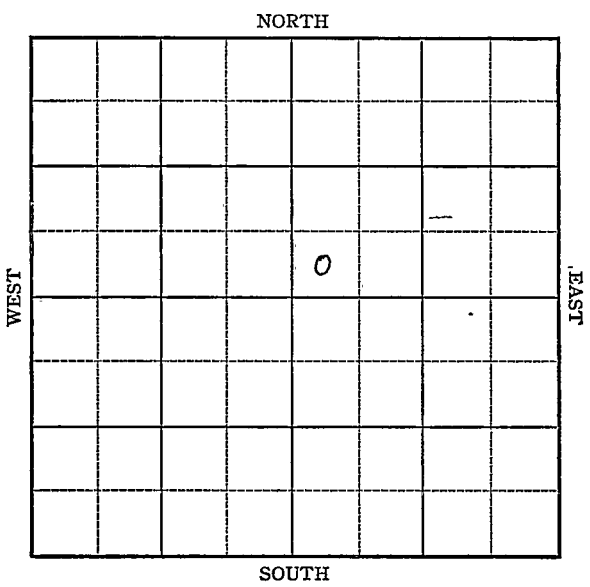

Sec. 12 Twp. 23 R. 10-W

Well No. # 2 Heylum "C" Farm

Cities Service Oil Company


Peace Creek

\_\_\_\_\_ Ft. from N. Line

330 Ft. from S. Line

\_\_\_\_\_ Ft. from E. Line

330 Ft. from W. Line

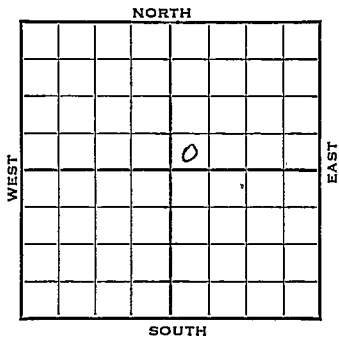

SW NE Elev. 1755

| 1943 | REPORT                                                                            |
|------|-----------------------------------------------------------------------------------|
| 1/13 | Location                                                                          |
| 1/20 | Surface hole                                                                      |
| 1/27 | 10" Casing set 190'<br>Drlg. 2550'                                                |
| 2/3  | Drlg. 2799'                                                                       |
| 2/10 | Drlg. 3637'                                                                       |
| 2/17 | Viola 3744<br>7" Casing set 3746<br>TD 3758 SO                                    |
| 2/24 | 250 acid Pump 27 bbls oil in 9 hrs.                                               |
| 3/3  | Viola 3744<br>7" @ 3746'<br>T.D. 3758'<br>250 Acid<br>Pump 472 Pot.<br>Gravity 42 |

**COMPLETED**

Reno

KANSAS

Map No. 7 Sec. 12 Twp. 23 R. 10WWell No. 2 Heylum "C"

Cities Service Oil Company

FIRST REPORT Contractor

SW NE

SECTION PLAT

\_\_\_\_\_ Ft. from N. Line

330 Ft. from S. Line

\_\_\_\_\_ Ft. from E. Line

330 Ft. from W. Line

|  |  |  |  |
|--|--|--|--|
|  |  |  |  |
|  |  |  |  |
|  |  |  |  |
|  |  |  |  |

PEACE CREEK POOL

Location XXX

Rig up \_\_\_\_\_

Drilling and Remarks:

RECORD

Cased \_\_\_\_\_ in., \_\_\_\_\_ ft.

Sand \_\_\_\_\_

Gas \_\_\_\_\_

Oil \_\_\_\_\_

Total Depth \_\_\_\_\_

PRODUCTION

1st 24 hrs. Nat. \_\_\_\_\_

1st 24 hrs. after shot \_\_\_\_\_

Gas \_\_\_\_\_ Cu. Ft.

Dry Hole \_\_\_\_\_

Abandoned \_\_\_\_\_

Date

JAN 13 1943 19S. I. LEWIS Scout

KANSAS

Map No. 47 Sec. 12 Twp. 23 R. 10W

Well No. 2 Heylum "C"

Cities Service Oil Company

COMPLETED Contractor

SECTION PLAT

SW NE

\_\_\_\_\_ Ft. from N. Line

330 Ft. from S. Line

\_\_\_\_\_ Ft. from E. Line

330 Ft. from W. Line

|  |  |   |  |
|--|--|---|--|
|  |  |   |  |
|  |  |   |  |
|  |  | 6 |  |
|  |  |   |  |
|  |  |   |  |

PEACE CREEK POOL

Location \_\_\_\_\_

Rig up \_\_\_\_\_

Drilling and Remarks:

*Viola 3744*

*7" @ 3746*

*250 cu. ft.*

*Pump 472 P.D.*

*42 @ 42*

RECORD

Cased \_\_\_\_\_ in., \_\_\_\_\_ ft.

Sand \_\_\_\_\_

Gas \_\_\_\_\_

Oil \_\_\_\_\_

Total Depth 3758

PRODUCTION

1st 24 hrs. Nat. \_\_\_\_\_

1st 24 hrs. after shot \_\_\_\_\_

Gas \_\_\_\_\_ Cu. Ft.

Dry Hole \_\_\_\_\_

Abandoned \_\_\_\_\_

Date

MAR 3 1943

19

S. J. LEWIS Scout