


Section 12 Township 23 Range 10-W

Well No. #2 Weiderbder

Company Lion Oil & Refining

NORTH Peace Creek Pool

13

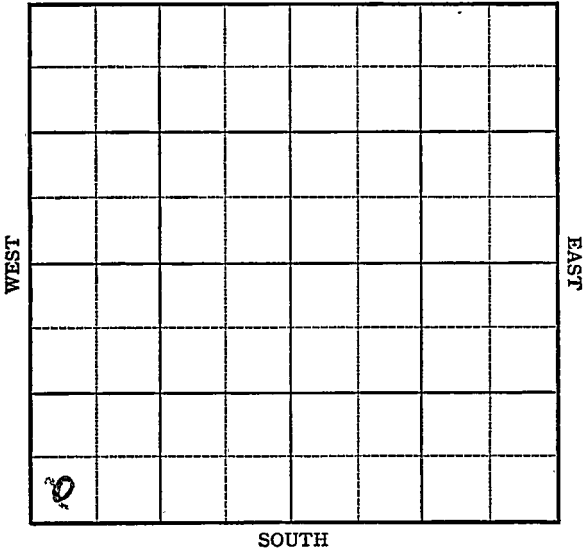

Sec. 12 Twp. 23 R. 10-W

Well No. #2 Weideroder Farm

Lion Oil & Refg. Company

(Peace Creek)


\_\_\_\_\_ Ft. from N. Line

330 Ft. from S. Line

\_\_\_\_\_ Ft. from E. Line

330 Ft. from W. Line

Elev. 1758

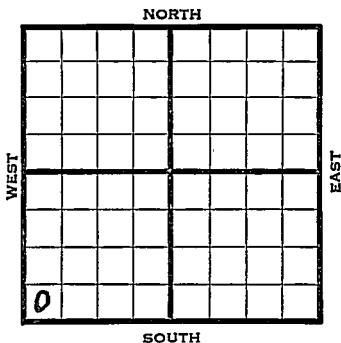

	REPORT
1942	
5/13	Location
5/20	Surface hole.
5/27	8" - 299' Drlg. 2355'
6/3	Lans. 3270' Viola 3751-53' T.D. 5" - 3751' RUST.
6/10	Viola 3751' 5" - 3751' T.D. 3759' 1000 acid. Bomb potential 7058 bbls. Maximum 3000 bbls. 42. Gravity
	<b>COMPLETED</b>

KANSAS

Reno

Map No. 47 Sec. 12 Twp. 23 R. 10WWell No. 2 WeideroderLion Oil & Refining CompanyFIRST REPORT Contractor

SW/C

## SECTION PLAT


\_\_\_\_\_ Ft. from N. Line

330 Ft. from S. Line

\_\_\_\_\_ Ft. from E. Line

330 Ft. from W. LinePEACE CREEK POOLLocation XXX

Rig up \_\_\_\_\_

Drilling and Remarks:

## RECORD

Cased \_\_\_\_\_ in., \_\_\_\_\_ ft.

Sand \_\_\_\_\_

Gas \_\_\_\_\_

Oil \_\_\_\_\_

Total Depth \_\_\_\_\_

## PRODUCTION

1st 24 hrs. Nat. \_\_\_\_\_

1st 24 hrs. after shot \_\_\_\_\_

Gas \_\_\_\_\_ Cu. Ft.

Dry Hole \_\_\_\_\_

Abandoned \_\_\_\_\_

Date

MAY 13 1942 19S. J. LEWIS Scout

