

Section 12 Township 23 Range 12W

Well No. #1 Brinkman

Company Lindsley Drlg.

NORTH

							0
							1

WEST

EAST

SOUTH

Sec. 12 Twp. 23 R. 12 W

Well No. # 1 Brinkman Farm

Lindsley Drlg. Company

Lindsley Brock Contractor


 Ft. from N. Line

330 Ft. from S. Line

330 Ft. from E. Line

 Ft. from W. Line

SE SE NE

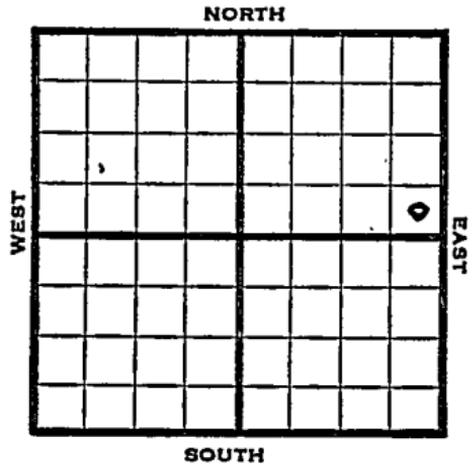

1952 Elev. 1829 REPORT

8/13 Spud 8-6-52
8" @ 220' Anhy 700'
Drlg. 2860'

8/20 Spud 8-6-52
D&A TD 3736
,8" @ 220 Anhy 700
Heeb. 3166 Br lime 3285
Lans. 3313
DST 3329-59 opn 1 hr.
Rec. 30' gcm Viola 3593
DST 3652-55 opn 1 hr.
Rec. 15' gcm 730#
Arb. 3720 TD 3736
D&A

ABANDONED

County Stafford State Kansas

Sec. 12 (Blk. Twp.) 23 (Sur. Rge.) 12W Map No.

Operator Lindsley Drlg.

Well No. 1 Farm Brinkman

Elev. _____ Location SE SE NE

FIRST REPORT

330 Ft. From S Line NE

330 Ft. From E Line Quarter

1st. Report AUG 13 1952

Completion _____

Remarks _____

Lindsley - Contr.

Spudding Date 8-6-52

Drlg. Data Brock

8" @ 220 Anhy 700 Drlg. 2860

